

JAN 25 2000

SECTION

Houghton County  
*Robert W. Cantor*  
Oct. 28, 1999  
For corners in

**LAND CORNER RECORDATION CERTIFICATE**  
Filing Requirement of Act 74, Mich. P.A. 1970

Houghton County	Located in:	Corner Code #
1. Public Land Survey	T55N R33W	I-5
	T R	
	T R	
	T R	
2. Property Controlling in Section	S T R	
	S T R	
3. Miscellaneous Property in Sec.	S T R	
	S T R	
4. Lot No. , Recorded Plat		
5. Private Claims		

Mary Schoos 1P  
 Register of Deeds  
 Houghton County, Register  
 Page 1 of 1 LC 4/51  
 PAU Date 12/30/1999 Time 10:36:04  
 CCC.

**Register of Deeds Stamp & File Number**

	A	B	C	D	E	F	G	H	I	J	K	L	M
1													
2	6		5		4		3		2		1		
3													
4	7		8		9		10		11		12		
5													
6	18		17		16		15		14		13		
7													
8	19		20		21		22		23		24		
9													
10	30		29		28		27		26		25		
11													
12	31		32		33		34		35		36		
13													

I, Joseph C. Domitrovich, in a field survey on September 24, 1999, do hereby state that under requirements of P.A. 74, Michigan P.A. of 1970, the corner points mentioned in lines 1 and 2 above were in conformance with regulations and rules therefore as required in the current manual of survey instructions of the United States Department of the Interior, Bureau of Land Management or by a decree of a Court of Law and /or that the corner points mentioned in lines 3, 4 and 5 above were in conformance with the rules of the Michigan Board of Land Surveyors or by a Decree of a Court of Law; established, re-established, monumented, recovered, found as expressed below:

NOTE: Not more than 2 corners, all in the same town and range, may be recorded on this certificate.

**A. Description of original monument and accessories and/or subsequent restoration:**

(1-5) Corner Common to Sections 10, 11, 14 & 15, T55N R33W.

1846 L.S. Scranton set a post with ties:

10" Sugar	S 47°W	13 links
6" Cedar	N 38°E	14 links

1910 D.W. Holland Set an iron pin in concrete. Calculations from his field notes (on file with Lake Superior Land Co. of Calumet) show distances to ¼ corners east and west.

1918 H.W. Fesing, Engineer, shows this corner in field notes and on a map of the subdivision of section 14, T55N, R33W, (both on file with Steve Hein, P.S., of Laurium). He shows it as an I.P. in concrete.

1996 Duane Wood re-established this corner at the intersection of centerline E-W Dover Road and extension of an old fenceline to the North. (Part of the Houghton Co. Airport Survey)

**B. Description of corner evidence found and/or method applied in restoring or reestablishing corner:**


I found no remains of the original corner or accessories. Duane Wood's ½" iron pin was removed by sewer line construction. The position of this corner was re-established from remaining survey control from Airport Survey. Carl Makkonen, a long time resident of the area, remembers a large iron pin at this same location before a snowplow removed it. Distances from this position to other corners in this section work fairly well with those noted by Holland and Fesing. I accepted it as the corner.

SE Corner, Section 15	S 01°18'59"E	5287.14' (m)	5290.8' (Fesing)
N ¼ Corner, Section 14	N 88°27'26"E	2653.62'	2638.21' (Holland)
N ¼ Corner, Section 15	S 88°32'35"W	2688.69' (m)	2694.95' (Holland) 2683.44' (Fesing)

**C. Description of monument for corner and accessories established to perpetuate locating the position of the corner:**

Corner is a ¾" iron pipe with a brass "Houghton County Remonumentation" cap on it. Ties:

10" Hard Maple	N 18°E	64.77'
12" Red Pine	S 40°E	46.74'
12" Red Pine	S 06°W	35.42'
7" Poplar	S 48°W	53.65'

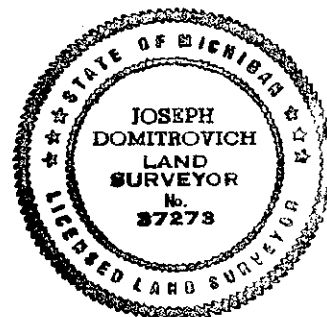

NOTE: Bearings to witness objects are magnetic. Distances are to a nail in side of the witness object unless noted.

Signed by *J. C. Domitrovich*

Date 10/22/99

Surveyor's Michigan License No. 37273