

JAN 25 2000

Houghton County
Robert W. Carpio
Oct. 28, 1999

LAND CORNER RECORDATION CERTIFICATE

Filing Requirement of Act 74, Mich. P.A. 1970

SECTION

For corners in

Houghton County	Located in:	Corner Code #
1. Public Land Survey	T55N R33W	1-6
	T R	
	T R	
	T R	
2. Property Controlling in Section	S T R	
	S T R	
3. Miscellaneous Property in Sec.	S T R	
	S T R	
4. Lot No.	Recorded Plat	
5. Private Claims		

Mary Schoos 1P
 Register of Deeds
 Houghton County, Register
 Page 1 of 1 LC 4/52
 PAU Date 12/30/1999 Time 10:36:45
 PFF. 9.000

Register of Deeds Stamp & File Number

	A	B	C	D	E	F	G	H	I	J	K	L	M
1													
2	6	5	4	3	2	1							
3													
4	7	8	9	10	11	12							
5													
6	18	17	16	15	14	13							
7													
8	19	20	21	22	23	24							
9													
10	30	29	28	27	26	25							
11													
12	31	32	33	34	35	36							
13													

I, Joseph C. Domitrovich, in a field survey on October 15, 1997, do hereby state that under requirements of P.A. 74, Michigan P.A. of 1970, the corner points mentioned in lines 1 and 2 above were in conformance with regulations and rules therefore as required in the current manual of survey instructions of the United States Department of the Interior, Bureau of Land Management or by a decree of a Court of Law and for that the corner points mentioned in lines 3, 4 and 5 above were in conformance with the rules of the Michigan Board of Land Surveyors or by a Decree of a Court of Law, established, re-established, monumented, recovered, found as expressed below:

NOTE: Not more than 2 corners, all in the same town and range, may be recorded on this certificate.

A. Description of original monument and accessories and/or subsequent restoration:

(1-6) 1/4 Corner Common to Sections 14 & 15, T55N, R33W.

1846 L.S. Scranton set a post with ties:

12" Yellow Birch	S 32°W	11 links
12" Sugar	N 61°E	10 links

1918 H.W. Fesing, Engineer, (on map and field notes on file with Steve Hein, P.S. of Laurium) reestablished corner position by single proportionate measurement but does not indicate that he set anything at it.

1997 Joseph C. Domitrovich, P.S. 37273 for Duane wood, P.S. 24625, re-established this corner by single proportionate measurement and set a 1/2" iron pin (part of Houghton Co. Airport Survey).

B. Description of corner evidence found and/or method applied in restoring or reestablishing corner:

I recovered the above 1/2" iron pin. Distances north, south and east work well with Fesing distances.

NW corner section 14	N 01°18'59"W	2643.57' m.	(2645.4' Fesing)
E 1/4 corner section 14	N 88°35'20"E	5279.98' m.	(5288.3' Fesing)
SW corner section 14	S 01°18'59"E	2643.57' m.	(2645.4' Fesing)


I accepted the iron pin as the corner and replaced it with a 3/4" iron pipe and cap.

C. Description of monument for corner and accessories established to perpetuate locating the position of the corner:

Corner is a 3/4" iron pipe with a Brass Houghton County Remonumentation cap placed on it. Ties:

4" Hard Maple	S 78°E	1.87'
6" Hard Maple	S 15°W	8.03'
8" Soft Maple	N 83°W	14.96'
6" Hard Maple	N 46°W	5.64'

NOTE: Bearings to witness objects are magnetic. Distances are to a nail in side of the witness object unless noted.

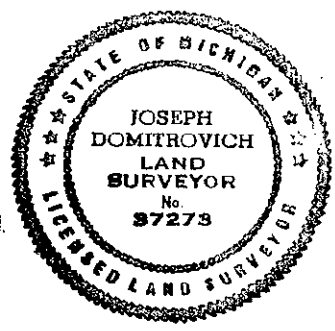

Signed by *J. C. Domitrovich*

Date 10/22/99

Surveyor's Michigan License No. 37273