

Surveyor
 Houghton County
Robert W. Cantor
 OCT 28, 1999

LAND CORNER RECORDATION CERTIFICATE
Filing Requirement of Act 74, Mich. P.A. 1970

JAN 25 2000

For corners in

Houghton County	Located in:	Corner Code #
1. Public Land Survey	T55N R33W	J - 5
	T R	
	T R	
	T R	
2. Property Controlling in Section	S T R	
	S T R	
3. Miscellaneous Property in Sec.	S T R	
	S T R	
4. Lot No.	Recorded Plat	
5. Private Claims		

Mary Schoos
 Register of Deeds
 Houghton County, Register
 Page 1 of 1
 PAU Date 12/30/1999
 LC 4/54
 Time 10:38:28
 9.00

Register of Deeds Stamp & File Number

	A	B	C	D	E	F	G	H	I	J	K	L	M
1													
2	6		5		4		3		2		1		
3													
4	7		8		9		10		11		12		
5													
6	18		17		16		15		14		13		
7													
8	19		20		21		22		23		24		
9													
10	30		29		28		27		26		25		
11													
12	31		32		33		34		35		36		
13													

I, Joseph C. Domitrovich, in a field survey on October 25, 1999, do hereby state that under requirements of P.A. 74, Michigan P.A. of 1970, the corner points mentioned in lines 1 and 2 above were in conformance with regulations and rules therefore as required in the current manual of survey instructions of the United States Department of the Interior, Bureau of Land Management or by a decree of a Court of Law and /or that the corner points mentioned in lines 3, 4 and 5 above were in conformance with the rules of the Michigan Board of Land Surveyors or by a Decree of a Court of Law, established, re-established, monumented, recovered, found as expressed below:

NOTE: Not more than 2 corners, all in the same town and range, may be recorded on this certificate.

A. Description of original monument and accessories and/or subsequent restoration:

(J - 5) 1/4 Corner Common to Sections 11 & 14, T55N, R33W.

- 1846 L.S. Scranton set a post with ties:
 10" Maple North 15 links
 6" Fir S72°W 14 links
- 1910 H.W. Holland shows this corner as a pin in concrete and gives a distance to Section corners east and west. (His notes on file with Lake Superior Land Company of Calumet)
- 1918 H.W. Fesing, Engineer, shows this corner as an I.P. in concrete, in his field notes and on his map of the Subdivision of Section 14, T55N, R33W. (On file with Steve Hein P.S. of Laurium)
- 1995 Steven Hein, P.S., 32336 recorded this corner. (L. 3, p. 301 of Corner Records) He found a 1 1/4" pin, bent with top portion broken off. He replaced it with a 5/8" pin. Ties:
 Utility Pole N 70°E 88.36'
 8" Aspen S 34°W 57.68'
 8" Spruce S 57°W 68.76'
 9" Spruce N 58°W 106.42'
- 1996 Duane Wood, P.S. 24625, accepted and used Steve Hein's 5/8" pin, as part of the Houghton County Airport Survey.

B. Description of corner evidence found and/or method applied in restoring or reestablishing corner:


I found no remains of the original corner or accessories. The 5/8" pin called for by Steve Hein has been removed by sewerline construction work. I re-established the position of his 5/8" pin using remaining survey control. This position works well with his 4 remaining bearing objects. It falls at approximate intersection of gravel county roads: Oneco Road to East and West and Dover Road to North. It works well with occupation and other corners in area. I accepted Steve Hein's position as the 1/4 corner.

C. Description of monument for corner and accessories established to perpetuate locating the position of the corner:

Corner is a 3/4" iron pipe with a brass "Houghton County Remonumentation" cap placed on it. Ties:

Utility Pole	N 71°E	88.31'	(Existing Nail & Tag)
8" Aspen	S 32°W	57.89'	(New nail)
8" Spruce	S 57°W	68.97'	(Existing Nail & Tag)
9" Spruce	N 58°W	106.42'	(Existing Nail & Tag)

NOTE: Bearings to witness objects are magnetic. Distances are to a nail in side of the witness object unless noted.

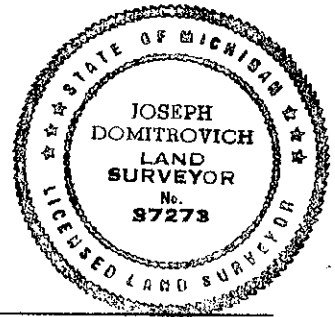

Signed by *J. C. Domitrovich*

Date 10/25/99

Surveyor's Michigan License No. 37273