

*Joseph W. Cranta*  
Oct. 28, 1999  
For corners in

**LAND CORNER RECORDATION CERTIFICATE**  
**Filing Requirement of Act 74, Mich. P.A. 1970**

JAN 25 2000

SECTION

- |                                    |               |               |
|------------------------------------|---------------|---------------|
| Houghton County                    | Located in:   | Corner Code # |
| 1. Public Land Survey              | T55N R33W     | J-7           |
|                                    | T R           |               |
|                                    | T R           |               |
|                                    | T R           |               |
| 2. Property Controlling in Section | S T R         |               |
|                                    | S T R         |               |
| 3. Miscellaneous Property in Sec.  | S T R         |               |
|                                    | S T R         |               |
| 4. Lot No.                         | Recorded Plat |               |
| 5. Private Claims                  |               |               |

Mary Schoos 1P  
Register of Deeds  
Houghton County, Register  
Page 1 of 1 LC 4/55  
PAU Date 12/30/1999 Time 10:39:23  
CCC.

**Register of Deeds Stamp & File Number**

I, Joseph C. Domitrovich, in a field survey on October 25, 1999, do hereby state that under requirements of P.A. 74, Michigan P.A. of 1970, the corner points mentioned in lines 1 and 2 above were in conformance with regulations and rules therefore as required in the current manual of survey instructions of the United States Department of the Interior, Bureau of Land Management or by a decree of a Court of Law and for that the corner points mentioned in lines 3, 4 and 5 above were in conformance with the rules of the Michigan Board of Land Surveyors or by a Decree of a Court of Law; established, re-established, monumented, recovered, found as expressed below:

NOTE: Not more than 2 corners, all in the same town and range, may be recorded on this certificate.

A. Description of original monument and accessories and/or subsequent restoration:

(J-7) 1/4 Corner Common to Sections 14 & 23, T55N, R33W.

1846 L.S. Scranton set a post with ties:

10" Yellow Birch	N 75°W	10 links
14" Sugar	S 02°E	24 links

1918 H.W. Fesing, Engineer, (Field notes in book 38, on files with Steve Hein, P.S., in Laurium) shows a position for this corner but does not indicate what it is. He shows distances West to the SW section corner and distance East to an I.P. on the section line.

B. Description of corner evidence found and/or method applied in restoring or reestablishing corner:


I found no remains of original corner or accessories. I found no evidence of subsequent restoration. I found the I.P. (2" iron pipe) called for by Fesing to the East and recovered his SW section corner to the West. I re-established a position for the 1/4 corner by prorating to Fesing's record distances. Distances from this position work well with Fesing's.

SW Corner Section 14	S 89°20'03"W	2639.00' measured	(2640.0' Fesing)
2" iron pipe on Section line	N 89°20'03E	1387.97' measured	(1388.5' Fesing)

C. Description of monument for corner and accessories established to perpetuate locating the position of the corner:

Corner is a 3/4" iron pipe with a brass Houghton County Remonumentation cap on it. Ties:

4" Hard Maple	N 79°E	4.14'
3" Hard Maple	S 42°E	24.19'
6" Soft Maple	N 84°W	25.30'
7" Oak in clump	N 37°W	27.99'

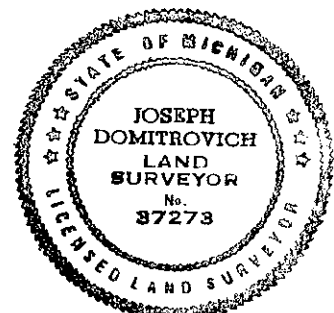

NOTE: Bearings to witness objects are magnetic. Distances are to a nail in side of the witness object unless noted.

Signed by *J. C. Domitrovich*

Date 10/22/99

Surveyor's Michigan License No. 37273