

SURVEY &
REMONUMENTATION

MAY 17 2000

267

LAND CORNER RECORDATION CERTIFICATE
Filing Requirement of Act 74, Mich. P.A. 1970

SECTION

For corners in
Houghton
(County)

Located In:

Corner Code #

- | | | | |
|--------------------------------------|---|-----------------------|--------------|
| 1. Public Land Survey | T | <u>55NR 33W</u> | <u>L-9</u> ✓ |
| | T | <u>55NR 33W</u> | <u>K-9</u> |
| | T | <u>55NR 33W</u> | <u>K-10</u> |
| | T | _____ R _____ | _____ |
| 2. Property Controlling in Section | S | _____ T _____ R _____ | _____ |
| | S | _____ T _____ R _____ | _____ |
| 3. Miscellaneous Property in Section | S | _____ T _____ R _____ | _____ |
| | S | _____ T _____ R _____ | _____ |

REGISTER'S OFFICE } ss.
Houghton County, Mich.

Received for record the 20th day
of July, A. D. 1995, at 11:00
o'clock, P.M. and recorded in Vol. 3
of Long Run Page 267
..... Friday, June 2, 1995
Register

Register of Deeds Stamp & File Number

4. Lot No. _____, Recorded Plat _____
5. Private Claims _____

A	B	C	D	E	F	G	H	I	J	K	L
2	6	5	4	3	2						
3											
4	7	8	9	10	11	12					
5											
6	18	17	16	15	14	13					
7											
8	19	20	21	22	23	24					
9											
10	30	29	28	27	26	25					
11											
12	31	32	33	34	35	36					
13											

Ronald S.

I, Haataja, in a field survey on August 11, 19 94, do hereby certify that under requirements of P.A. 74, Michigan P.A. of 1970, the corner points mentioned in lines 1 and 2 above were in conformance with regulations and rules therefore as required in the current manual of survey instructions of the United States Department of the Interior, Bureau of Land Management or by a decree of a Court of Law and/or that the corner points mentioned in lines 3, 4 and 5 above were in conformance with the rules of the Michigan Board of Professional Surveyors or by a Decree of a Court of Law; established, re-established, monumented, re-monumented, recovered, found as expressed below:


NOTE: Not more than 4 corners, all in the same town and range, may be recorded on this certificate.

A. Description of original monument and accessories and/or subsequent restoration: (From orig. notes dated 1846)

- L-9 (S1/4 corner Sec 24) Set qr. Sec Post, Fir 12" N72E 261ks, Hemlock 14" S79W 171ks.
- K-9 (SW corner Sec 24) Set Post cor Secs 23, 24, 25 & 26 from which Hemlock 12" S23W 251ks, Y. Birch 16" N36E 311ks.
- K-10 (W1/4 corner Sec 25) Set qr. Sec Post, Sugar 10" S12W 101ks, Maple 6" N73E 211ks.

B. Description of corner evidence found and/or method applied in restoring or reestablishing corner:

- L-9 Restored at intersection of fences East-West and South.
- K-9 Restored at intersection of old wire fence to East and painted line South.
- K-10 Restored at 12" W. Pine with Keweenaw Land Assoc. tag and at intersection of painted line North and East from corner.

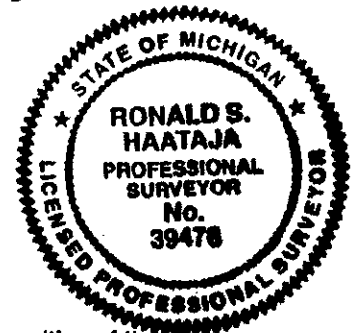

C. Description of monument for corner and accessories established to perpetuate locating the position of the corner:

- | | |
|--|--|
| L-9 Set 1" I.D. by 36" pipe witnesses: | K-9 Set 1" I.D. by 36" pipe witnesses: |
| S59W 2.73' 5" Maple | S40E 31.03' 10" Maple |
| N37W 12.30' 8" Maple | N80W 29.75' 10" Oak |
| S8W 15.02' 16" Maple | N15E 23.30' 10" Maple |
| N64E 14.88' 5" Maple | S40W 3.86' 10" Maple |

K-10 Set 1" I.D. by 36" pipe witnesses: S30E 13.52' 10" W. Pine, N38E 0.92' 12" W. Pine, S60W 15.27' 8" Oak, N46W 21.22' 2" Maple.

Signed by Ronald S. Haataja
Surveyor's Michigan License No. 39478

Date July 20, 1995