

**SURVEY & REMONUMENTATION**

**JAN 09 1998**

**LAND CORNER RECORDATION CERTIFICATE**  
**Filing Requirement of Act 74, Mich. P.A. 1970**

**SECTION**

APPROVED LAND CORNER  
 Houghton County

SEPT. 23, 1997  
 Robert W. Crampton

For corners in  
HOUGHTON  
 (County)

Located In:

Corner Code #

- |                                      |   |            |   |            |
|--------------------------------------|---|------------|---|------------|
| 1. Public Land Survey                | T | <u>55N</u> | R | <u>34W</u> |
|                                      | T | <u>54N</u> | R | <u>34W</u> |
|                                      | T | _____      | R | _____      |
|                                      | T | _____      | R | _____      |
| 2. Property Controlling in Section   | S | _____      | T | _____      |
|                                      | S | _____      | T | _____      |
| 3. Miscellaneous Property in Section | S | _____      | T | _____      |
|                                      | S | _____      | T | _____      |

I-12, I-13  
I-1

NANCY FENILI 09/23/97  
 HOUGHTON COUNTY 14:35  
 LC 3/ 431 PAU Fee: 9.00  
 Page 1 of 1

Register of Deeds Stamp & File Number

4. Lot No. \_\_\_\_\_, Recorded Plat \_\_\_\_\_  
 5. Private Claims \_\_\_\_\_

A	B	C	D	E	F	G	H	I	J	K	L	M
2	6	5	4	3	2	1						
3												
4	7	8	9	10	11	12						
5												
6	16	17	16	15	14	13						
7												
8	19	20	21	22	23	24						
9												
10	30	29	28	27	26	25						
11												
12	31	32	33	34	35	36						
13												

I, R. W. CRAMPTON, in a field survey on NOVEMBER 19, 1991, do hereby certify that under requirements of P.A. 74, Michigan P.A. of 1970, the corner points mentioned in lines 1 and 2 above were in conformance with regulations and rules therefore as required in the current manual of survey instructions of the United States Department of the Interior, Bureau of Land Management or by a decree of a Court of Law and/or that the corner points mentioned in lines 3, 4 and 5 above were in conformance with the rules of the Michigan Board of Professional Surveyors or by a Decree of a Court of Law; established, re-established, monumented, re-monumented, recovered, found as expressed below:

NOTE: Not more than 4 corners, all in the same town and range, may be recorded on this certificate.

A. Description of original monument and accessories and/or subsequent restoration:


- I-12 POST SET, FIR 12 S61W 35, CEDAR 10 N51W 36.  
I-13 55-34 & I-1 54-34 POST SET, HEMLOCK 14 N61E, BIRCH 12 N7W.

B. Description of corner evidence found and/or method applied in restoring or reestablishing corner:

- I-12 3/4" THICK WALL IRON PIPE FOUND FROM IRONS FOUND IN THE RECORDED PLAT OF NAUMKEG SHORES, REPLACED WITH 3/4" I.D. IRON PIPE WITH 2 3/4" BRASS CAP. PREVIOUSLY RECORDED BY R. W. CRAMPTON, LIBER 2, PAGE 807.  
I-13 55-34 & I-1 54-34 1" ROUND IRON PIN FOUND FROM ORIGINAL GOVERNMENT LAND OFFICE NOTES AND OTHER SURVEYS IN SECTION 35, T55N, R34W, SET 1" IRON PIPE WITH 2 1/2" BRASS CAP OVER 1" IRON PIN. PREVIOUSLY RECORDED BY R. W. CRAMPTON, LIBER 2, PAGE 807.

C. Description of monument for corner and accessories established to perpetuate locating the position of the corner:

- I-12 3/4" IRON PIPE WITH BRASS CAP, WITNESSED WITH SURVEY TAG  
7" CHERRY TREE N3°E 18.97', 6" MAPLE TREE S25°W 78.34',  
12p NAIL FOUND IN A 4" CHERRY TREE S51°E 15.95', 7" APPLE TREE N77°W 29.20'.  
I-13 55-34 & I-1 54-34 1" IRON PIPE WITH BRASS CAP, WITNESSED WITH SURVEY TAG NAILED TO:  
9" OAK TREE N40°E 10.87', 4" HEMLOCK TREE S78°E 42.35', 5" MAPLE TREE S21°E 29.28',  
11" MAPLE TREE N20°W 30.30', EAST 4.67' TO THE NORTHWEST CORNER OF SECTION 2, T54N, R34W.

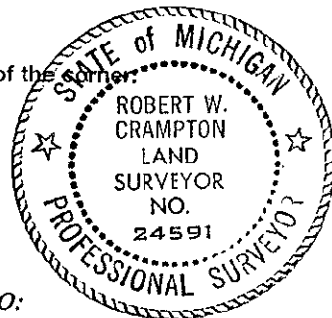

Signed by Robert W. Crampton  
 Surveyor's Michigan License No. 24591

Date AUG. 26, 1997