

SEP. 28, 1997
Robert W. Crampton

LAND CORNER RECORDATION CERTIFICATE
Filing Requirement of Act 74, Mich. P.A. 1970

SURVEY &
REMONUMENTATION

JAN 09 1998

For corners in
HOUGHTON
(County)

Located In:

Corner Code #

SECTION

1. Public Land Survey T 55N R 34W
T 54N R 34W
T _____ R _____
T _____ R _____
2. Property Controlling S _____ T _____ R _____
in Section S _____ T _____ R _____
3. Miscellaneous S _____ T _____ R _____
Property in Section S _____ T _____ R _____

J-13
J-1

NANCY FENILI 09/23/97
HOUGHTON COUNTY
LC 3/ 423 PAU Fee: 14:31
Page 1 of 1 9.00

Register of Deeds Stamp & File Number

4. Lot No. _____, Recorded Plat _____
5. Private Claims _____

| | A | B | C | D | E | F | G | H | I | J | K | L | M |
|----|----|---|----|---|----|---|----|---|----|---|----|---|---|
| 2 | 6 | | 5 | | 4 | | 3 | | 2 | | | | |
| 3 | | | | | | | | | | | | | |
| 4 | 7 | | 8 | | 9 | | 10 | | 11 | | 12 | | |
| 5 | | | | | | | | | | | | | |
| 6 | 18 | | 17 | | 16 | | 15 | | 14 | | 13 | | |
| 7 | | | | | | | | | | | | | |
| 8 | 19 | | 20 | | 21 | | 22 | | 23 | | 24 | | |
| 9 | | | | | | | | | | | | | |
| 10 | 30 | | 29 | | 28 | | 27 | | 26 | | 25 | | |
| 11 | | | | | | | | | | | | | |
| 12 | 31 | | 32 | | 33 | | 34 | | 35 | | 36 | | |
| 13 | | | | | | | | | | | | | |

I, R. W. CRAMPTON, in a field survey on SEPTEMBER 17, 1979
do hereby certify that under requirements of P.A. 74, Michigan P.A. of 1970, the corner points mentioned
in lines 1 and 2 above were in conformance with regulations and rules therefore as required in the current
manual of survey instructions of the United States Department of the Interior, Bureau of Land
Management or by a decree of a Court of Law and/or that the corner points mentioned in lines 3, 4 and
5 above were in conformance with the rules of the Michigan Board of Professional Surveyors or by a
Decree of a Court of Law; established, re-established, monumented, re-monumented, recovered, found
as expressed below:

NOTE: Not more than 4 corners, all in the same town and range, may be recorded
on this certificate.

A. Description of original monument and accessories and/or subsequent restoration:


J-13 55-34 & J-1 54-34 SET QUARTER SECTION POST, BIRCH 18, NS9E 26, FIR 10 N17W 21.

B. Description of corner evidence found and/or method applied in restoring or reestablishing corner:

J-13 55-34 & J-1 54-34 1" IRON ROD ENCASED IN CONCRETE DATED 1908. SET 1" IRON PIPE WITH 2 1/4" BRASS CAP OVER 1" IRON ROD. THE ORIGINAL TOWNSHIP DRAWING INDICATES A DOUBLE CORNER AT THIS LOCATION. THE ORIGINAL FIELD NOTES DO NOT. OLD SURVEYS AND MAPS AS FAR BACK AS 1916 INDICATE THIS HAS BEEN USED AS A SINGLE CORNER. PREVIOUSLY RECORDED BY ROBERT MICK, LIBER 2, PAGE 807.

C. Description of monument for corner and accessories established to perpetuate locating the position of the corner:

*J-13 55-34 & J-1 54-34 1" IRON PIPE WITH BRASS CAP, WITNESSED WITH SURVEY TAG NAILED TO:
4" CEDAR TREE N52°E 14.35', 5" CEDAR TREE S81°W 5.59',
9" CEDAR TREE S12°W 27.75', N47°W TO CENTER OF A SQUARE PLUG ON A 2 1/4" IRON PIPE.*

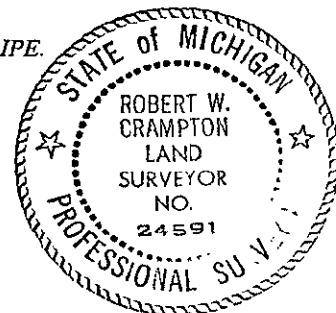

Signed by Robert W. Crampton

Date Aug. 26, 1997

Surveyor's Michigan License No. 24591