

Ronald W. Campa  
OCT. 28, 1999

**LAND CORNER RECORDATION CERTIFICATE**  
**Filing Requirement of Act 74, Mich. P.A. 1970**

JAN 25 2000

For corners in  
Houghton  
 (County)

Located In:

Corner Code #

SECTION

- 1. Public Land Survey T 55N R 34W  
 T \_\_\_ R \_\_\_  
 T \_\_\_ R \_\_\_  
 T \_\_\_ R \_\_\_
- 2. Property Controlling S \_\_\_ T \_\_\_ R \_\_\_  
 in Section S \_\_\_ T \_\_\_ R \_\_\_
- 3. Miscellaneous S \_\_\_ T \_\_\_ R \_\_\_  
 Property in Section S \_\_\_ T \_\_\_ R \_\_\_

K-7  
 Mary Schoos 1P  
 Register of Deeds  
 Houghton County, Register  
 Page 1 of 1 LC 4/63  
 PAU Date 12/30/1999 Time 10:51:13  
 9.00  
**Register of Deeds Stamp & File Number**

- 4. Lot No. \_\_\_\_\_, Recorded Plat \_\_\_\_\_
- 5. Private Claims \_\_\_\_\_


Ronald S. Haataja, in a field survey on October 8, 19 97, do hereby certify that under requirements of P.A. 74, Michigan P.A. of 1970, the corner points mentioned in lines 1 and 2 above were in conformance with regulations and rules therefore as required in the current manual of survey instructions of the United States Department of the Interior, Bureau of Land Management or by a decree of a Court of Law and/or that the corner points mentioned in lines 3, 4 and 5 above were in conformance with the rules of the Michigan Board of Professional Surveyors or by a Decree of a Court of Law; established, re-established, monumented, re-monumented, recovered, found as expressed below:

**NOTE: Not more than 4 corners, all in the same town and range, may be recorded on this certificate.**

A	B	C	D	E	F	G	H	I	J	K	L	A
2	6		5		4		3		2		1	
3												
4	7		8		9		10		11		12	
5												
6	18		17		16		15		14		13	
7												
8	19		20		21		22		23		24	
9												
10	30		29		28		27		26		25	
11												
12	31		32		33		34		35		36	
13												

**A. Description of original monument and accessories and/or subsequent restoration:**

(K-7) NW corner Section 24, T55N-R34W  
 80.00 Set post corner of Sections 13, 14, 23, 24  
 References: Maple 8" S66°W 20 lks.  
 Yellow Birch 16" N08°E 22 lks.

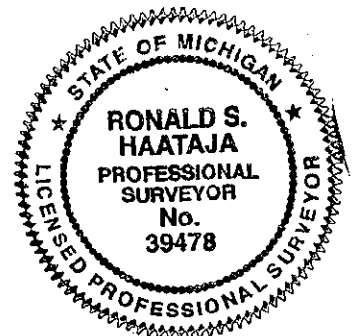

**B. Description of corner evidence found and/or method applied in restoring or reestablishing corner:**

(K-7) NW corner Section 24, T55N-R34W  
 Record (1876) Iron Pin in large piece of granite  
 Field notes at MTU Archives: "At a pt. in the center of MRRR track 26.4 ft. SW'ly from NE face of S.W. abutment of railroad bridge and distant from 1/4 corner North side of Section 24 2652.9 ft. Section corner was afterwards marked by an iron pin in a large piece of granite buried below ties."

I recovered the iron pin in granite (approx. 3' below grade) in a field survey in 1997.

**C. Description of monument for corner and accessories established to perpetuate locating the position of the corner:**

(K-7) NW corner Section 24, T55N-R34W  
 Accepted the Iron Pin as the corner. Raised to surface by driving in a 1 1/2" iron pipe and cementing on a brass Houghton County Remonumentation cap.  
 Witnesses: Brass Tags PS#39478 nailed into side of trees  
 10" Aspen N88°W 23.00'  
 3" Ironwood N35°E 40.29'  
 6" Maple S19°E 42.60'  
 10" Aspen S65°W 61.89'

Signed by Ronald S. Haataja

Date October 20, 1999

Surveyor's Michigan License No. 39478