

JAN 09 1998

LAND CORNER RECORDATION CERTIFICATE
 Filing Requirement of Act 74, Mich. P.A. 1970

SECTION

SEPT. 23, 1997
 Robert W. Crampton
 For corners in
HOUGHTON
 (County)

Located In: _____ Corner Code # _____


1. Public Land Survey	T	<u>55N</u>	R	<u>34W</u>	<u>K-9, K-10</u>
	T	_____	R	_____	_____
	T	_____	R	_____	_____
	T	_____	R	_____	_____
2. Property Controlling in Section	S	_____	T	_____	_____
	S	_____	T	_____	_____
3. Miscellaneous Property in Section	S	_____	T	_____	_____
	S	_____	T	_____	_____

NANCY FENILI 09/23/97 #
 HOUGHTON COUNTY 14:35
 LC 3/ 433 PAU Fee: 9.00
 Page 1 of 1

Register of Deeds Stamp & File Number

4. Lot No. _____, Recorded Plat _____
 5. Private Claims _____

I, R. W. CRAMPTON, in a field survey on SEPTEMBER 8, 19 87, do hereby certify that under requirements of P.A. 74, Michigan P.A. of 1970, the corner points mentioned in lines 1 and 2 above were in conformance with regulations and rules therefore as required in the current manual of survey instructions of the United States Department of the Interior, Bureau of Land Management or by a decree of a Court of Law and/or that the corner points mentioned in lines 3, 4 and 5 above were in conformance with the rules of the Michigan Board of Professional Surveyors or by a Decree of a Court of Law; established, re-established, monumented, re-monumented, recovered, found as expressed below:

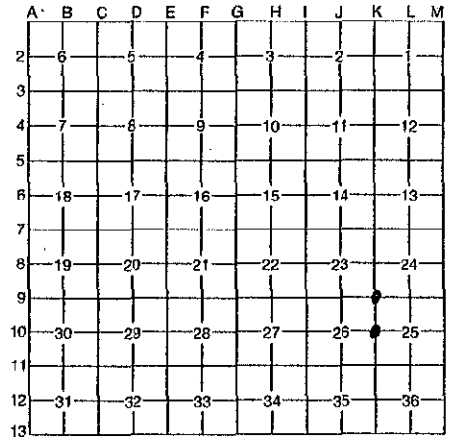

NOTE: Not more than 4 corners, all in the same town and range, may be recorded on this certificate.

A. Description of original monument and accessories and/or subsequent restoration:

K-9 ORIGINAL POST OR ACCESSORIES NOT FOUND. CORNER COMMON TO SECTION 23, 24, 25 & 26.
K-10 ORIGINAL POST OR ACCESSORIES NOT FOUND. 1/4 CORNER BETWEEN SECTION 26 & 25.

B. Description of corner evidence found and/or method applied in restoring or reestablishing corner:

K-9 FOUND: 3/4" IRON PIN FLUSH WITH GROUND, SET COUPLING WITH 2 1/4" BRASS CAP OVER 3/4" PIN. PREVIOUSLY RECORDED BY BRIAN R. TAAVOLA, LIBER 2, PAGE 541.
K-10 FOUND: 7/8" ROUND DRILL SHAFT PROJECTING 6" ABOVE GROUND, REPLACED WITH 1/2" IRON PIPE WITH 2 1/4" BRASS CAP. PREVIOUSLY RECORDED BY BRIAN R. TAAVOLA, LIBER 2, PAGE 543.

C. Description of monument for corner and accessories established to perpetuate locating the position of the corner:

K-9 COUPLING WITH BRASS CAP, WITNESSED WITH SURVEY TAG NAILED TO: POWER POLE N54°W 15.65', 1/2" REROD (LOT CORNER) N62°E 42.50', N23°W 47.19' TO SE CORNER OF HOUSE, N04°E 66.33' TO NE CORNER OF HOUSE.
K-10 1/2" IRON PIPE WITH BRASS CAP, WITNESSED WITH SURVEY TAG NAILED TO: 6" WHITE BIRCH TREE S45°W 5.96', 4" TWIN MAPLE TREE N35°W 8.98', 4" MAPLE TREE N75°E 4.12', 3" MAPLE TREE S65°E 11.05'.



Signed by Robert W. Crampton Date Aug. 26, 1997
 Surveyor's Michigan License No. 24591