

SEPT. 23, 1997.
Robert W. Crampton
For corners in
HOUGHTON
(County)

LAND CORNER RECORDATION CERTIFICATE
Filing Requirement of Act 74, Mich. P.A. 1970

SURVEY &
REMONUMENTATION

JAN 09 1998

SECTION

- 1. Public Land Survey T _____ R _____
T _____ R _____
T _____ R _____
T _____ R _____
- 2. Property Controlling S 1 T 54N R 34W _____
in Section S 6 T 54N R 33W _____
Miscellaneous S 31 T 55N R 33W _____
Property in Section S 36 T 55N R 34W _____
- 4. Lot No. _____, Recorded Plat _____
- 5. Private Claims _____

NANCY FENILI 09/23/97
HOUGHTON COUNTY 14:34
LC 3/ 428 PAU Fee: 9.00
Page 1 of 1

Register of Deeds Stamp & File Number

	A	B	C	D	E	F	G	H	I	J	K	L	M
2	6		5		4		3		2		1		
3													
4	7		8		9		10		11		12		
5													
6	18		17		16		15		14		13		
7													
8	19		20		21		22		23		24		
9													
10	30		29		28		27		26		25		
11													
12	31		32		33		34		35		36		
13													

I, R. W. CRAMPTON, in a field survey on SEPTEMBER 30, 1983, do hereby certify that under requirements of P.A. 74, Michigan P.A. of 1970, the corner points mentioned in lines 1 and 2 above were in conformance with regulations and rules therefore as required in the current manual of survey instructions of the United States Department of the Interior, Bureau of Land Management or by a decree of a Court of Law and/or that the corner points mentioned in lines 3, 4 and 5 above were in conformance with the rules of the Michigan Board of Professional Surveyors or by a Decree of a Court of Law; established, re-established, monumented, re-monumented, recovered, found as expressed below:

NOTE: Not more than 4 corners, all in the same town and range, may be recorded on this certificate.

A. Description of original monument and accessories and/or subsequent restoration:

THIS IS THE CORNER COMMON TO FOUR TOWNSHIPS AND SECTIONS:
SECTION 1, T54N, R34W, CODE M-1, SECTION 6, T54N, R33W, CODE A-1, SECTION 31, T55N, R33W, CODE A-13, SECTION 36, T55N, R34W, CODE M-13.


THE CORNER IS ON THE NORTH EDGE OF "OLD" SHARRON AVE, EAST OF GARNET IN HOUGHTON. PROBABLY RESTORED FROM THE ORIGINAL BY CIVIL ENGINEERING DEPARTMENT AT MTU, USED SINCE 1966 BY SURVEYORS IN FORESTRY DEPT AT MTU.

B. Description of corner evidence found and/or method applied in restoring or reestablishing corner:

THE MONUMENT WAS OBLITERATED BY A CITY OF HOUGHTON CREW REPLACING A BROKEN WATER MAIN LOCATED DIRECTLY BELOW IT, IN THE FALL OR EARLY WINTER OF 1982. THE MONUMENT SET WAS A STANDARD MONUMENT; 36" LONG, CONSISTING OF A 1/2" REBAR ENCASED IN A 3 1/2" CYLINDER OF CONCRETE. AN "X" WAS FILED IN THE EXPOSED END OF THE REBAR. THE MONUMENT WAS SET WITH ITS TOP APPROXIMATELY 6" BELOW THE SURFACE IN ORDER TO PROTECT IT FROM GRADING EQUIPMENT, SET 1/2" IRON PIPE WITH 2 1/2" BRASS CAP OVER RE-ROD IN MON. PREVIOUSLY RECORDED BY ROSWELL K. MILLER IN LIBER 1, PAGE 893.

C. Description of monument for corner and accessories established to perpetuate locating the position of the corner:

THE 1/2" IRON PIPE WITH 2 1/2" BRASS CAP WITNESSED WITH SURVEY TAG NAILED TO:
12" WHITE BIRCH TREE N26°W 36.93', 20" MAPLE TREE N29°E 40.17',
18" MAPLE TREE N65°E 68.55', 26" MAPLE TREE S20°W 39.89'.

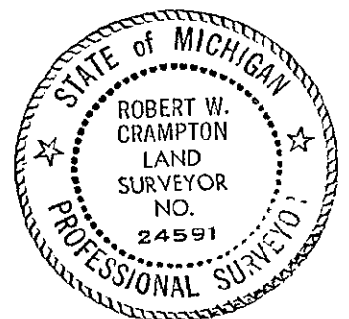

Signed by *Robert W. Crampton* Date Aug. 26, 1997
Surveyor's Michigan License No. 24591