

OCT 08 1997

NOV 21 1997

COMMISSION

COMMISSION

LAND CORNER RECORDATION CERTIFICATE
Filing Requirement of Act 74, Mich. P.A. 1970

For corners in KEWEENAW (County)

Located In:

Corner Code #

- 1. Public Land Survey T 32W R 32W
2. Property Controlling in Section S T R
3. Miscellaneous Property in Section S T R

H-13 H-01
I-12

REGISTER'S OFFICE
County of Keweenaw
Received for Record, the 29th day of July A.D. 1997
at 10:00 o'clock A.M., and Recorded in Liber of LCR on page 167
Register of Deeds

Register of Deeds Stamp & File Number

- 4. Lot No. Recorded Plat
5. Private Claims

Grid table with columns A-L and rows 1-13. Contains numbers 1-36 and a small dot in row 12, column 34.


I, R.W. CRAMPTON, in a field survey on MAY 30, 19 85, do hereby certify that under requirements of P.A. 74, Michigan P.A. of 1970, the corner points mentioned in lines 1 and 2 above were in conformance with regulations and rules therefore as required in the current manual of survey instructions of the United States Department of the Interior, Bureau of Land Management or by a decree of a Court of Law and/or that the corner points mentioned in lines 3, 4 and 5 above were in conformance with the rules of the Michigan Board of Professional Surveyors or by a Decree of a Court of Law; established, re-established, monumented, re-monumented, recovered, found as expressed below:

NOTE: Not more than 4 corners, all in the same town and range, may be recorded on this certificate.

- A. Description of original monument and accessories and/or subsequent restoration:
H-13 SOUTH 1/4 CORNER-SET POST-SUGAR 10 N50E 25, SUGAR 10 N46W 24.
I-12 EAST 1/4 CORNER-SET POST-SUGAR 18 S40W 21, Y. BIRCH 8 N40E 27.

Ratified by Peer Group
In accordance with P.A. 345
Co. Rep. [Signature]
Date 7/29/97

- B. Description of corner evidence found and/or method applied in restoring or reestablishing corner:
H-13 SOUTH 1/4 CORNER-1 1/2" IRON PIPE FOUND AND SET WITH 4" BRASS CAP.
I-12 EAST 1/4 CORNER-1" IRON PIPE FOUND IN THE CENTERLINE OF AN OLD ROAD AND ON A PROJECTION OF AN OLD FENCE EAST OF THE CORNER AND SET WITH 4" BRASS CAP.

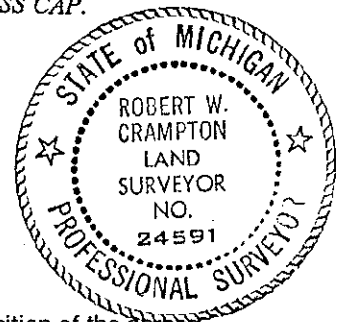

- C. Description of monument for corner and accessories established to perpetuate locating the position of the corner:
H-13 THE 1 1/2" IRON PIPE WITH 4" BRASS CAP WAS WITNESSED WITH SURVEY TAG NAILED TO:
14" OAK TREE N15 W 6.55', 8" OAK TREE N25 E 7.96',
8" OAK TREE S81 E 14.86', 7" OAK TREE S30 W 8.37'.
I-12 THE 1" IRON PIPE WITH 4" BRASS CAP WAS WITNESSED WITH SURVEY TAG NAILED TO:
8" TWIN MAPLE TREE S79 E 18.85', 12" MAPLE TREE S13 E 66.31',
5" MAPLE TREE S40 W 36.10', 8" ASPEN TREE N70 W 19.60'.

Signed by [Signature]
Surveyor's Michigan License No. 24591

Date July 22, 1997