

OCT 29 1996

Re-Monumented, Page 27

COMMISSION REMONUMENTATION

LAND CORNER RECORDATION CERTIFICATE Filing Requirement of Act 74, Mich. P.A. 1970

For Corners in	Located in:	Corner Code #
<u>Huron</u> (County)		
1. Public Land survey: Grant	T <u>15 N</u> R <u>11 E</u>	<u>A-13</u>
	T _____ R _____	_____
	T _____ R _____	_____
	T _____ R _____	_____
2. Property Controlling in Section	S _____ T _____ R _____	_____
	S _____ T _____ R _____	_____
3. Miscellaneous	S _____ T _____ R _____	_____
4. Lot No. _____, Recorded Plat _____		
5. Private Claims _____		

STATE OF MICHIGAN HURON COUNTY RECORDED

12 SEP 96 11:23 A.M.

FRANCES L. HOLDWICK REGISTER OF DEEDS

Register of Deeds Stamp & File Number

I, James T. Meek, in a field survey on August 30, 1996, do hereby certify that under requirements of P.A. 74, Michigan P.A. of 1970, the corner points mentioned in lines 1 and 2 above were in conformance with regulations and rules thereof as required in the current manual of survey instructions of the United States Department of the Interior, Bureau of Land Management or by a decree of a Court of Law and/or that the corner points mentioned in lines 3, 4 and 5 above were in conformance with the rules of the Michigan Board of Land Surveyors or by a Decree of a Court of Law; established, re-established, monumented, re-monumented, recovered, found as expressed below:

A	B	C	D	E	F	G	H	I	J	K	L	M
2	6	5	4	3	2	1						
3												
4	7	8	9	10	11	12						
5												
6	18	17	16	15	14	13						
7												
8	19	20	21	22	23	24						
9												
10	30	29	28	27	26	25						
11												
12	31	32	33	34	35	36						
13												

NOTE: Not more than 4 corners, all in the same town and range, may be recorded on this certificate.

A. Description of original monument and accessories and/or subsequent restoration:
Original survey, South Bdy. T15NR11E, 1835, Harvey Parke D.S.
A-13 Corner of Townships 14 and 15 North, Ranges 10 and 11 East
Post
Beech 16", N21°W, 28½ links
Beech 28", S24°W, 44 links

No County Surveyor's Record, recorded surveys or LCRC


B. Description of corner evidence found and/or method applied in restoring or reestablishing corner:
A-13 Corner of Townships 14 and 15 North, Ranges 10 and 11 East

Found T iron, 2" below grd.
1W' East of the centerline of BayPort Rd. (N #)
At the intersection with Huron Line Rd. and Gaytown Rd.

Accepted as the best available evidence of the original corner position.

C. Description of monument for corner and accessories established to perpetuate locating the position of the corner:
A-13 Corner of Townships 14 and 15 North, Ranges 10 and 11 East

Set ½" iron with cap #39089, 3" below grd. over T iron
from which:
Nail in power pole bears South, 24.2'
Nail in power pole bears S80°W, 136.5'
½" iron flush w/grd. bears N47°W, 22.0'
½" iron flush w/grd. bears N60°E, 40.1'

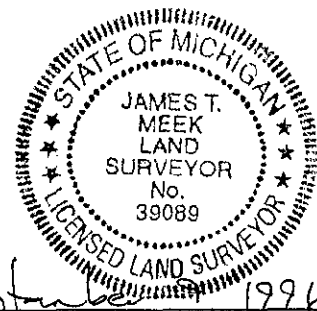

Signed by James T. Meek

Date September 27, 1996

Surveyor's Michigan License No. 39089

APPROVED AT PEER BOARD MEETING 9-9-96 RUB