

SURVEY & REMONUMENTATION

DEC 16 1996

Re-Mon. Liberl, Page 29

REMONUMENTATION

LAND CORNER RECORDATION CERTIFICATE
Filing Requirement of Act 74, Mich. P.A. 1970

For Corners in
Huron
(County)

Located in: _____ Corner Code # _____

1. Public Land survey Grant T 15 N R 11 E D-13
T _____ R _____ E-13
T _____ R _____
T _____ R _____

2. Property Controlling in Section S _____ T _____ R _____
S _____ T _____ R _____

3. Miscellaneous S _____ T _____ R _____

4. Lot No. _____, Recorded Plat _____

5. Private Claims _____

STATE OF MICHIGAN
HURON COUNTY
RECORDED

30 OCT 96 9:46 A.M.

FRANCES L. HOLDWICK
REGISTER OF DEEDS

Register of Deeds Stamp & File Number

	A	B	C	D	E	F	G	H	I	J	K	L	M
2	6		5		4		3		2		1		
3													
4	7		8		9		10		11		12		
5													
6	18		17		16		15		14		13		
7													
8	19		20		21		22		23		24		
9													
10	30		29		28		27		26		25		
11													
12	31		32		33		34		35		36		
13													

I, James T. Meek, in a field survey on October 11, 1996, do hereby certify that under requirements of P.A. 74, Michigan P.A. of 1970, the corner points mentioned in lines 1 and 2 above were in conformance with regulations and rules thereof as required in the current manual of survey instructions of the United States Department of the Interior, Bureau of Land Management or by a decree of a Court of Law and/or that the corner points mentioned in lines 3, 4 and 5 above were in conformance with the rules of the Michigan Board of Land Surveyors or by a Decree of a Court of Law; established, re-established, monumented, re-monumented, recovered, found as expressed below:

NOTE: Not more than 4 corners, all in the same town and range, may be recorded on this certificate.

A. Description of original monument and accessories and/or subsequent restoration:
Original Survey South Bdy. T15NR11E, 1835, Harvey Parke, D.S.

D-13: South ¼ Corner of Section 32
Post
Spruce 6", N64½°E, 9 links
Spruce 6", N58°W, 27 links

E-13: Corner of Sections 32 & 33
Post
Hemlock 10", N82½°E, 6 links
B. Ash 12", N43°W, 21½ links

No County surveyors record, recorded surveys or LCRC

No County surveyors record, recorded surveys or LCRC

B. Description of corner evidence found and/or method applied in restoring or reestablishing corner:

D-13: South ¼ Corner of Section 32

E-13: Corner of Sections 32 & 33

Fence post at the intersection of old fence lines bearing North, East and South.

There is no remaining evidence of the original corner position.

Accepted as the best available evidence of the original corner position.

C. Description of monument for corner and accessories established to perpetuate locating the position of the corner:

D-13: South ¼ Corner of Section 32

E-13: Corner of Sections 32 & 33


Set 'T' iron with cap #39089
At intersection of fence lines bearing North, East and South
From which:
Nail in Triple Maple 18" bears North, 18.0'
Nail in Poplar 8" bears West, 4.7'
Nail in Elm 8" bears South 3.2'
Nail in poplar 14" bears S50°E, 42.5'

At proportionate distance,
Set ½" iron w/cap #39089, 3" below grd.
At the NE corner of the intersection of Huron Line Rd and Farver Rd.
From which:
Wood post by TB bears N20°E, 11.9'
Nail in power pole bears S4°E, 45.1'
Road sign post bears N83°W, 36.15'
Dead end sign post bears S83°W, 56.7'

Signed by [Signature]
Surveyor's Michigan License No. 39089

Date 10-29-96

APPROVED AT PEER BOARD MEETING, 10-29-96
RLB CSG gm
S.L.L.

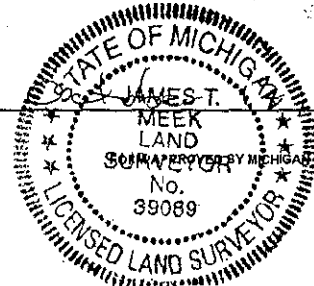

STATE OF MICHIGAN BOARD OF LAND SURVEYORS, JAN. 23, 1971
REVISED MAY 14, 1975
REVISED JAN., 1983