

DEC 16 1996

COMMISSION

Re-Mon. Liber 1, Page 30

REMONUMENTATION

LAND CORNER RECORDATION CERTIFICATE
Filing Requirement of Act 74, Mich. P.A. 1970

For Corners in
Huron
(County)

Located in: Corner Code #

1. Public Land survey Grant T 15 N R 11 E F-13
T _____ R _____ G-13
T _____ R _____
T _____ R _____

2. Property Controlling S _____ T _____ R _____
in Section S _____ T _____ R _____

3. Miscellaneous S _____ T _____ R _____

4. Lot No. _____, Recorded Plat _____

5. Private Claims _____

STATE OF MICHIGAN
HURON COUNTY
RECORDED

30 OCT 96 9:46 A.M.

FRANCES L. HOLLOWICK
REGISTER OF DEEDS

Register of Deeds Stamp & File Number

	A	B	C	D	E	F	G	H	I	J	K	L	M
2	6		5		4		3		2		1		
3													
4	7		8		9		10		11		12		
5													
6	18		17		16		15		14		13		
7													
8	19		20		21		22		23		24		
9													
10	30		29		28		27		26		25		
11													
12	31		32		33		34		35		36		
13													

I, James T. Meek, in a field survey on October 11, 1996, do hereby certify that under requirements of P.A. 74, Michigan P.A. of 1970, the corner points mentioned in lines 1 and 2 above were in conformance with regulations and rules thereof as required in the current manual of survey instructions of the United States Department of the Interior, Bureau of Land Management or by a decree of a Court of Law and/or that the corner points mentioned in lines 3, 4 and 5 above were in conformance with the rules of the Michigan Board of Land Surveyors or by a Decree of a Court of Law; established, re-established, monumented, re-monumented, recovered, found as expressed below:

NOTE: Not more than 4 corners, all in the same town and range, may be recorded on this certificate.

A. Description of original monument and accessories and/or subsequent restoration:
Original Survey South Bdy. T15NR11E, 1835, Harvey Parke, D.S.

F-13	South 1/4 Corner of Section 33 Post Cedar 15", N61°W, 16 links Cedar 9", N68°E, 10 links No county surveyors record, recorded surveys or LCRC	G-13	Corner of Sections 33 and 34 Post Hemlock 10", N72 1/2°E, 13 links Cedar 8", N55 1/2°W, 10 links County Surveyors Record: 1" iron pin Rowe Engineering: iron pin No recorded surveys or LCRC
------	---	------	--

B. Description of corner evidence found and/or method applied in restoring or reestablishing corner:


F-13	South 1/4 Corner of Section 33 There is no remaining evidence of the original corner position.	G-13	Corner of Sections 33 and 34 Found 1" iron in mon box Accepted as the best available evidence of the original corner position.
------	---	------	--

C. Description of monument for corner and accessories established to perpetuate locating the position of the corner:

F-13	South 1/4 Corner of Section 33 At proportionate position Set 1/2" iron with cap #39089, 3" below grd. Centerline of Maharg Rd, bears, East, 5' Centerline of Huron Line Rd. bears South, 5' From which: Stop sign post bears N34°W, 19.1' Huron County sign post bears N20°E, 53.1' West leg of Dir. sign post bears South, 18.8' Wood post by TB bears N50°W, 31.6'	G-13	Corner of Sections 33 and 34 1" iron in mon box From which: Wood post by TB bears N60°W, 64.2' Stop sign post bears S27°W, 14.3' Huron County sign post bears N22°E, 105.4' Wood post by TB bears S70°E, 93.3' 1/2" iron in mon box bears East, 56.75'
------	---	------	---

Signed by [Signature] Date 10-29-96
Surveyor's Michigan License No. 39089

APPROVED AT PEER BOARD MEETING, 10-29-96
RLB CSG JM
RLD

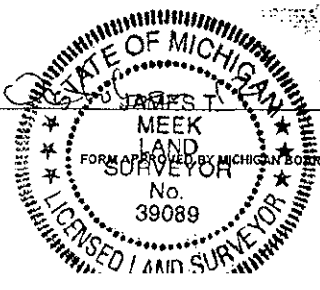

1996
FORM APPROVED BY MICHIGAN BOARD OF LAND SURVEYORS, JAN. 28, 1971
REVISED MAY 14, 1975
REVISED JAN., 1983