

REMONUMENTATION

DEC 1 6 1996

COMMISSION

Re-Mon. Liber 1, Page 32

REMONUMENTATION

LAND CORNER RECORDATION CERTIFICATE
Filing Requirement of Act 74, Mich. P.A. 1970

For Corners in

	<u>Huron</u> (County)	Located in:	Corner Code #
1. Public Land survey Grant		T 15 N R 11 E	J-13
		T _____ R _____	K-13
		T _____ R _____	
		T _____ R _____	
2. Property Controlling in Section	S _____	T _____ R _____	
	S _____	T _____ R _____	
3. Miscellaneous	S _____	T _____ R _____	

STATE OF MICHIGAN
HURON COUNTY
RECORDED

30 OCT 96 9:47 A.M.

FRANCES L. HOLDWICK
REGISTER OF DEEDS

Register of Deeds Stamp & File Number

- 4. Lot No. _____, Recorded Plat _____
- 5. Private Claims _____

	A	B	C	D	E	F	G	H	I	J	K	L	M
2	6	5	4	3	2	1							
3													
4	7	8	9	10	11	12							
6													
6	18	17	16	15	14	13							
7													
8	19	20	21	22	23	24							
9													
10	30	29	28	27	26	25							
11													
12	31	32	33	34	35	36							
13													

I, James T. Meek, in a field survey on October 11, 1996, do hereby certify that under requirements of P.A. 74, Michigan P.A. of 1970, the corner points mentioned in lines 1 and 2 above were in conformance with regulations and rules thereof as required in the current manual of survey instructions of the United States Department of the Interior, Bureau of Land Management or by a decree of a Court of Law and/or that the corner points mentioned in lines 3, 4 and 5 above were in conformance with the rules of the Michigan Board of Land Surveyors or by a Decree of a Court of Law, established, re-established, monumented, re-monumented, recovered, found as expressed below:

NOTE: Not more than 4 corners, all in the same town and range, may be recorded on this certificate.

A. Description of original monument and accessories and/or subsequent restoration:
Original Survey South Bdy. T15NR11E, 1835, Harvey Parke, D.S.

- | | | | |
|------|--|------|---|
| J-13 | South 1/4 Corner of Section 35
Post
Beech 12", N58°E, 13 links
Beech 9", N89°W, 40 links | K-13 | Corner of Sections 35 and 36
Post
Hemlock 30", N70 1/2°E, 43 links
Hemlock 9", N84°W, 19 1/2 links |
| | No county surveyors record, Rowe Eng: 3/4" pipe
Liber 3, Page 63 HCR: 3/4" pipe
Liber 4, Page 689 HCR: 3/4" pipe | | No county surveyors record,
recorded surveys or LCRC. |

B. Description of corner evidence found and/or method applied in restoring or reestablishing corner:

- | | | | |
|------|--|------|--|
| J-13 | South 1/4 Corner of Section 35

Found 3/4" pipe, 4" below grd.
Centerline of Huron Line Rd. bears North, 2'

Accepted as the best available evidence
of original corner position | K-13 | Corner of Sections 35 and 36

Found 1" iron, 6" below grd.
At centerline Huron Line Rd., 1' East of
centerline Moore Rd.

Accepted as the best available evidence
of original corner position |
|------|--|------|--|

C. Description of monument for corner and accessories established to perpetuate locating the position of the corner:


- | | | | |
|------|--|------|--|
| J-13 | South 1/4 Corner of Section 35

Set 1/2" iron w/cap #39089, 3" below grd.
over 3/4" pipe
From which:
Nail in power pole bears N10°E, 50.1'
Nail in 12" Box Elder bears S16°E, 66.6'
1/2" iron flush w/grd. bears S48°W, 25.0'
1/2" iron flush w/grd. bears N27°W, 20.0'
3/4" pipe bears East, 31.3' | K-13 | Corner of Sections 35 and 36

Set 1/2" iron w/cap #39089, 3" below ground
over 1" iron
From which:
Nail in wood post bears S50°E, 56.5'
Road sign post bears N36°W, 33.2'
West direct. sign post bears N42°E, 27.9'
East direct. sign post bears S6°W, 24.0'
3/4" iron, 5" below grd. bears East, 31.2' |
|------|--|------|--|

Signed by James T. Meek
Surveyor's Michigan License No. 39089

Date 1996

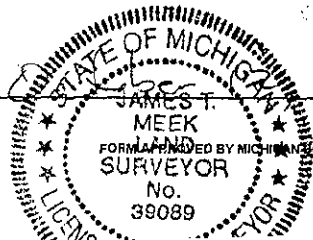

APPROVED AT PEER BOARD MEETING, 10-29-96
RLB CSG 9/11