

*Common to A01 -- Sheridan Twp. - T15N-R12E
 *Common to A13 - Colfax Twp. - T16N-R12E
 *Common to M13 - Oliver Twp. - T16N-R11E

Re-Mon Liber 1 Page 114

REMONUMENTATION

LAND CORNER RECORDATION CERTIFICATE
 Filing Requirement of Act 74, Mich. P.A. 1970

For Corners in

STATE OF MICHIGAN
 HURON COUNTY
 RECORDED

Huron Located in: Corner Code #
 (County)

1. Public Land survey: Grant T 15 N R 11 E
 T 16N R 11E
 T 15N R 12E
 T 16N R 12E

2. Property Controlling S ___ T ___ R ___
 in Section S ___ T ___ R ___

3. Miscellaneous S ___ T ___ R ___

M-1
M-13
A-1
A-13

**SURVEY &
 REMONUMENTATION**
 JAN 22 1998
 SECTION

DEC 97 11:11 A.M.
 FRANCES L. HOLDWICK
 REGISTER OF DEEDS

Register of Deeds Stamp & File Number

4. Lot No. _____, Recorded Plat _____
 5. Private Claims _____

I, James T. Meek, in a field survey on October 30, 1997, do hereby certify that under requirements of P.A. 74, Michigan P.A. of 1970, the corner points mentioned in lines 1 and 2 above were in conformance with regulations and rules thereof as required in the current manual of survey instructions of the United States Department of the Interior, Bureau of Land Management or by a decree of a Court of Law and/or that the corner points mentioned in lines 3, 4 and 5 above were in conformance with the rules of the Michigan Board of Land Surveyors or by a Decree of a Court of Law; established, re-established, monumented, re-monumented, recovered, found as expressed below:

	A	B	C	D	E	F	G	H	I	J	K	L	M
2	6		5		4		3		2		1		
3													
4	7		8		9		10		11		12		
5													
6	18		17		16		15		14		13		
7													
8	19		20		21		22		23		24		
9													
10	30		29		28		27		26		25		
11													
12	31		32		33		34		35		36		
13													

NOTE: Not more than 4 corners, all in the same town and range, may be recorded on this certificate.


A. Description of original monument and accessories and/or subsequent restoration:
 Original survey, East Bdy. T15NR11E, 1835, Harvey Parke D.S.
 M-1 Corner of Townships 15 and 16 North, Ranges 11 and 12 East
 Post
 Beech 17", N17°E, 15 links
 Beech 17", S30°W, 18 links
 County surveyors record: none
 Recorded surveys: L4, P12
 LCRC: none

B. Description of corner evidence found and/or method applied in restoring or reestablishing corner:
 M-1 Corner of Townships 15 and 16 North, Ranges 11 and 12 East
 Found iron in rock collar, 3' deep
 At the intersection of Kilmanagh Rd. and Grassmere Rd.
 Accepted as the best available evidence of the original corner position.

C. Description of monument for corner and accessories established to perpetuate locating the position of the corner:
 C-1 Corner of Townships 15 and 16 North, Ranges 11 and 12 East
 Set 1/2" iron w/cap # 39089 over iron
 From which:
 Road sign post bears N62°E, 35.7'
 1/2" iron flush w/grd. bears S45°E, 30.0'
 Tag in BP bears S47°W, 71.5'
 Gas line sign post bears N50°W, 51.85'

Signed by [Signature]
 Surveyor's Michigan License No. 39089

Date _____

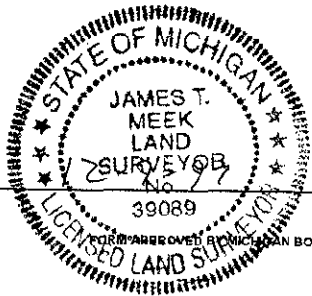

APPROVED AT PEER BOARD MEETING Nov 25, 1997 RLB