

- \*Common to A13 - Colfax Twp. - T16N-R12E
- \*Common to M13 - Oliver Twp. - T16N-R11E
- \*Common to M01 - Grant Twp. - T15N-R11E

Re-Mon. Liber 1, Page 113

REMONUMENTATION

LAND CORNER RECORDATION CERTIFICATE  
Filing Requirement of Act 74, Mich. P.A. 1970

For Corners in

<u>Huron</u> (County)	Located in:	Corner Code #
1. Public Land survey: <u>Sheridan</u>	T <u>15</u> N R <u>12</u> E	<u>A-1</u> ✓
	T <u>16N</u> R <u>12E</u>	<u>A-13</u>
	T <u>15N</u> R <u>11E</u>	<u>M-1</u>
	T <u>16N</u> R <u>11E</u>	<u>M-13</u>
2. Property Controlling	S _____ T _____ R _____	_____
in Section	S _____ T _____ R _____	_____
3. Miscellaneous	S _____ T _____ R _____	_____

SURVEY & REMONUMENTATION

JAN 22 1998

SECTION

Register of Deeds

STATE OF MICHIGAN  
HURON COUNTY  
RECORDED

9 DEC 97 11:10 A.M.

FRANCES L. HOLDWICK

REGISTER OF DEEDS

- 4. Lot No. \_\_\_\_\_, Recorded Plat \_\_\_\_\_
- 5. Private Claims \_\_\_\_\_

I, James T. Meek, in a field survey on October 30, 1997, do hereby certify that under requirements of P.A. 74, Michigan P.A. of 1970, the corner points mentioned in lines 1 and 2 above were in conformance with regulations and rules thereof as required in the current manual of survey instructions of the United States Department of the Interior, Bureau of Land Management or by a decree of a Court of Law and/or that the corner points mentioned in lines 3, 4 and 5 above were in conformance with the rules of the Michigan Board of Land Surveyors or by a Decree of a Court of Law; established, re-established, monumented, re-monumented, recovered, found as expressed below:

A	B	C	D	E	F	G	H	I	J	K	L	M
2	6	5	4	3	2	1						
3												
4	7	8	9	10	11	12						
5												
6	18	17	16	15	14	13						
7												
8	19	20	21	22	23	24						
9												
10	30	29	28	27	26	25						
11												
12	31	32	33	34	35	36						
13												

NOTE: Not more than 4 corners, all in the same town and range, may be recorded on this certificate.


A. Description of original monument and accessories and/or subsequent restoration:  
Original survey, West Bdy. T15NR12E, 1835, Harvey Parke D.S.  
A-i Corner of Townships 15 and 16 North, Ranges 11 and 12 East  
Post  
Beech 17", N17°E, 15 links  
Beech 17", S30°W, 18 links  
  
County surveyors record: none  
Recorded surveys: L4, P12  
LCRC: none

B. Description of corner evidence found and/or method applied in restoring or reestablishing corner:  
A-1 Corner of Townships 15 and 16 North, Ranges 11 and 12 East  
  
Found iron in rock collar, 3' deep  
At the intersection of Kilmanagh Rd. and Grassmere Rd.  
  
Accepted as the best available evidence of the original corner position.

C. Description of monument for corner and accessories established to perpetuate locating the position of the corner:  
A-1 Corner of Townships 15 and 16 North, Ranges 11 and 12 East  
  
Set 1/2" iron w/cap # 39089 over iron  
  
From which:  
Road sign post bears N62°E, 35.7'  
1/2" iron flush w/grd. bears S45°E, 30.0'  
Tag in PP bears S47°W, 71.5'  
Gas line sign post bears N50°W, 51.85'

igned by [Signature]  
urveyor's Michigan License No. 39089

Date \_\_\_\_\_

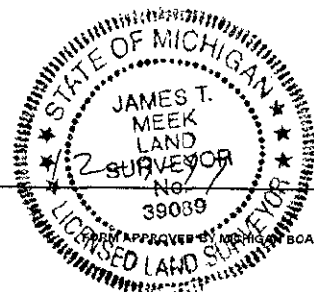

APPROVED AT PEER BOARD MEETING Nov 25, 1997 RLB