

# SURVEY & REMONUMENTATION

MAR 19 1997

COMMISSION

1996

*Re-Mon Liber 1, Page 46*

REMONUMENTATION

## LAND CORNER RECORDATION CERTIFICATE Filing Requirement of Act 74, Mich. P.A. 1970

For corners in Sheridan Township

Huron County <small>(County)</small>	Located in:	Corner Code #
1. Public Land Survey	T <u>15N</u> R <u>12E</u>	F-13
	T <u>   </u> R <u>   </u>	_____
	T <u>   </u> R <u>   </u>	_____
	T <u>   </u> R <u>   </u>	_____
2. Property Controlling in Section	S <u>   </u> T <u>   </u> R <u>   </u>	_____
	S <u>   </u> T <u>   </u> R <u>   </u>	_____
3. Miscellaneous Property in Sec.	S <u>   </u> T <u>   </u> R <u>   </u>	_____
	S <u>   </u> T <u>   </u> R <u>   </u>	_____

STATE OF MICHIGAN  
HURON COUNTY  
RECORDED

7 NOV 96 4:07 P.M.

FRANCES L. HOLDWICK  
REGISTER OF DEEDS

Register of Deeds Stamp & File Number

4. Lot No. \_\_\_\_\_, Recorded Plat \_\_\_\_\_  
5. Private Claims \_\_\_\_\_

I, Russell L. Brown, in a field survey on Oct. 16, 1996 do hereby state that under requirements of P.A. 74, Michigan P.A. of 1970, the corner points mentioned in lines 1 and 2 above were in conformance with regulations and rules therefore as required in the current manual of survey instructions of the United States Department of the Interior, Bureau of Land Management or by a decree of a Court of Law and/or that the corner points mentioned in lines 3, 4 and 5 above were in conformance with the rules of the Michigan Board of Land Surveyors or by a Decree of a Court of Law; established, re-established, monumented, recovered, found as expressed below:

**NOTE:** Not more than 2 corners, all in the same town and range, may be recorded on this certificate.

1	A	B	C	D	E	F	G	H	I	J	K	L	M
2		5		5		4		3		2		1	
3													
4		7		8		9		10		11		12	
5													
6		18		17		16		15		14		13	
7													
8		19		20		21		22		23		24	
9													
10		30		29		28		27		26		25	
11													
12		31		32		33		34		35		36	
13													

**A. Description of original monument and accessories and/or subsequent restoration:**

1834 G.L.O., H. Parke D.S.  
Set quarter Section Post  
Cedar 8", N60E 14 Links  
B. Ash 8", N33W 21 Links

County Road Commission Records:  
NONE

County Surveyor Records:  
NONE

(OVER)

**B. Description of corner evidence found and/or method applied in restoring or reestablishing corner:**


Found 5/8" Steel Stake, raised with 3/4" Pipe, capped RLS 24588, centerline gravel road East and West, fence row North, raised to 5"+ below surface.

Accepted: Found 5/8" Steel Stake as the best evidence of the corner original position for corner F-13.

**C. Description of monument for corner and accessories established to perpetuate locating the position of the corner:**

South 1/4 Corner Section 33, T15N-R12E R-13  
Found 5/8" Steel Stake, raised with 3/4" Pipe capped RLS 24588

WITNESSES:  
S45°E 22.86' to 1/2" Dia. Steel Stake capped RLS 24588  
S25°W 27.32' to Notch in South End 18" C.M.P.  
N25°W 26.94' to Notch in North End 18" C.M.P.  
N45°E 36.29' to 1/2" x 18" Steel Stake capped RLS 24588

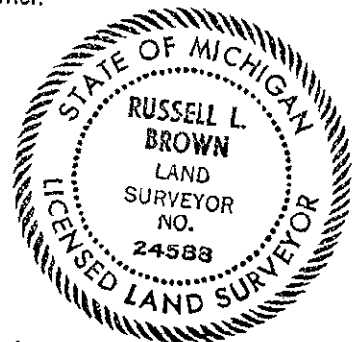

Signed by Russell L. Brown  
Surveyor's Michigan License No. 24588

Date 11-05-96

PEER GROUP APPROVED  
AT MEETING 11-05-96

*Liber 1, Page 46A*

May 1, 1979 Survey recorded in Liber 4 of surveys on Page 51 of Huron County Records.

5/8" Iron Pin

Spike in Southeast Side of 24" Ash Tree, S55°W 53.75'

Spike in Northeast Side of 14" Ash Tree, N65°W 63.83'

1/2" Steel Pin, North 31.0'

October 23, 1984 Survey by Huron Surveying (Project No. 84-611).

5/8" Re-Rod

N50°W 52.90' to Nail in North Side 24" Ash Tree

N70°W 63.49' to Nail in South Side 14" Ash Tree

N50°E 34.13' to 1/2" Steel Stake