

**SURVEY & REMONUMENTATION**

MAR 19 1997

COMMISSION

1996

*Re-Mon Likew 1, Page 47*

REMONUMENTATION

**LAND CORNER RECORDATION CERTIFICATE**  
Filing Requirement of Act 74, Mich. P.A. 1970

For corners in Sheridan Township

<u>Huron County</u> (County)	Located in:	Corner Code #
1. Public Land Survey	T <u>15N</u> R <u>12E</u>	G-13
	T _____ R _____	_____
	T _____ R _____	_____
	T _____ R _____	_____
2. Property Controlling in Section	S _____ T _____ R _____	_____
	S _____ T _____ R _____	_____
3. Miscellaneous Property in Sec.	S _____ T _____ R _____	_____
	S _____ T _____ R _____	_____

STATE OF MICHIGAN  
HURON COUNTY  
RECORDED  
7 NOV 96 4:07 P.M.  
FRANCES L. HOLDWICK  
REGISTER OF DEEDS  
Register of Deeds Stamp & File Number

4. Lot No. \_\_\_\_\_, Recorded Plat \_\_\_\_\_  
5. Private Claims \_\_\_\_\_

I, Russell L. Brown, in a field survey on Oct. 16, 19 96 do hereby state that under requirements of P.A. 74, Michigan P.A. of 1970, the corner points mentioned in lines 1 and 2 above were in conformance with regulations and rules therefore as required in the current manual of survey instructions of the United States Department of the Interior, Bureau of Land Management or by a decree of a Court of Law and/or that the corner points mentioned in lines 3, 4 and 5 above were in conformance with the rules of the Michigan Board of Land Surveyors or by a Decree of a Court of Law; established, re-established, monumented, recovered, found as expressed below:

NOTE: Not more than 2 corners, all in the same town and range, may be recorded on this certificate.

	A	B	C	D	E	F	G	H	I	J	K	L	M
1													
2		6		5		4		3		2		1	
3													
4		7		8		9		10		11		12	
5													
6		18		17		16		15		14		13	
7													
8		19		20		21		22		23		24	
9													
10		30		29		28		27		26		25	
11													
12		31		32		33		34		35		36	
13													

A. Description of original monument and accessories and/or subsequent restoration:

1834 G.L.O., H. Parke D.S.  
Set Post Corner Sections 33 and 34

County Road Commission Records:  
Iron Pin  
Spike Ash, N65°E 97.50'  
Spike 30" Cottonwood, N20°E 106.70'

County Surveyors Records:  
NONE

Act 74 L.C.R.C.  
NONE  
(OVER)

No unrecorded surveys found.

B. Description of corner evidence found and/or method applied in restoring or reestablishing corner:

Found 3/4" Pipe centerline gravel road North, East and West 4"± below Surface, capped R.L.S. 24588.

Accepted: Found 3/4" Pipe as the best evidence of the original corner position for Corner G-13.


C. Description of monument for corner and accessories established to perpetuate locating the position of the corner:

Corner Sections 33 and 34, T15N-R12E G-13

Found 3/4" Pipe, capped R.L.S. 24588

WITNESSES:

- N35°W 47.31' to Notch West End C.M.P.
- S40°W 82.31' to Notch East End of 18" C.M.P.
- S55°E 34.19' to "+" on head of railroad spike in top of guard rail post
- N45°E 71.90' to Large Bolt South Side Power Pole

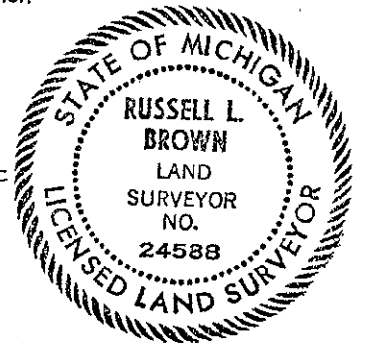

Signed by Russell L. Brown  
Surveyor's Michigan License No. 24588

Date 11-05-96

PEER GROUP APPROVED  
AT MEETING 11-05-96

Liber 1, Page 47A

May 1, 1979 Survey Liber 4 of Surveys on Page 51 of Huron County Records.

3/4" Steel Pin

Spike in East Side Power Pole, N30°E 72.75'

Spike in Northeast Side Telephone Pole, N45°W 49.10'

Steel Fence Post, N45°E 52.0'