

SURVEY & REMONUMENTATION

MAR 19 1997

COMMISSION

1996

Re-Mon Liber 1, Page 49
REMONUMENTATION

LAND CORNER RECORDATION CERTIFICATE
Filing Requirement of Act 74, Mich. P.A. 1970

For corners in Sheridan Township

Huron County (County)	Located In:	Corner Code #
1. Public Land Survey	T <u>15N</u> R <u>12E</u>	<u>I-13</u>
	T ___ R ___	_____
	T ___ R ___	_____
	T ___ R ___	_____
2. Property Controlling in Section	S ___ T ___ R ___	_____
	S ___ T ___ R ___	_____
3. Miscellaneous Property in Sec.	S ___ T ___ R ___	_____
	S ___ T ___ R ___	_____

STATE OF MICHIGAN
HURON COUNTY
RECORDED
7 NOV 96 4:07 P.M.
FRANCES L. HOLDWICK
REGISTER OF DEEDS
Register of Deeds Stamp & File Number

4. Lot No. _____, Recorded Plat _____
5. Private Claims _____

	A	B	C	D	E	F	G	H	I	J	K	L	M
1													
2		6		5		4		3		2		1	
3													
4		7		8		9		10		11		12	
5													
6		10		17		16		15		14		13	
7													
8		19		20		21		22		23		24	
9													
10		30		29		28		27		26		25	
11													
12		31		32		33		34		35		36	
13													

I, Russell L. Brown, in a field survey on Oct. 16, 1996 do hereby state that under requirements of P.A. 74, Michigan P.A. of 1970, the corner points mentioned in lines 1 and 2 above were in conformance with regulations and rules therefore as required in the current manual of survey instructions of the United States Department of the Interior, Bureau of Land Management or by a decree of a Court of Law and/or that the corner points mentioned in lines 3, 4 and 5 above were in conformance with the rules of the Michigan Board of Land Surveyors or by a Decree of a Court of Law; established, re-established, monumented, recovered, found as expressed below:

NOTE: Not more than 2 corners, all in the same town and range, may be recorded on this certificate.

A. Description of original monument and accessories and/or subsequent restoration:

1834 G.L.O., H. Parke D.S.
Set Post Corner Sections 34 and 35
Cedar 26", N50°E 13 Links
Cedar 8", N69W 28 Links

County Road Commission Records:
NONE

Act 74, L.C.R.C.
NONE

November 12, 1885, County Surveyor Records:
Henry Strudwick County Surveyor
Survey Section 35, T15N-R12E, Corner established proportionate measurements. No object or accessories given

No recorded or unrecorded surveys found.


B. Description of corner evidence found and/or method applied in restoring or reestablishing corner.

Found 1/2" Steel Stake, centerline gravel road East and West, 6'+ West gravel road North and South, 3"+ below surface.

Accepted: Found 1/2" Steel Stake as the best evidence of the original corner position of Corner I-13.

C. Description of monument for corner and accessories established to perpetuate locating the position of the corner:

Corner Sections 34 and 35, T15N-R12E I-13
Found 1/2" Steel Stake
WITNESSES:
N25°W 58.26' to Spike in East Side 32" Cottonwood Tree
S40°W 36.72' to Notch in West End 18" C.M.P.
N40°E 47.91' to Notch is South End 18" C.M.P.
S45°E 50.65' to P.K. Nail in Northeast Side Power Pole

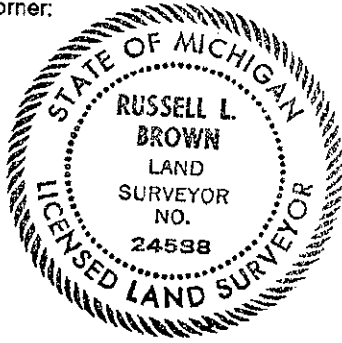

Witnessed by Russell L. Brown
Surveyor's Michigan License No. 24588

Date 11-05-96

PEER GROUP APPROVED
AT MEETING 11-05-96
[Signatures]