

**SURVEY & REMONUMENTATION**

MAR 19 1997

COMMISSION

1996. REMONUMENTATION

*Re-Monumentation, Page 50*

**LAND CORNER RECORDATION CERTIFICATE**  
Filing Requirement of Act 74, Mich. P.A. 1970

For corners in Sheridan Township

<u>Huron County</u> (County)	Located In:	Corner Code #
1. Public Land Survey	T <u>15</u> N R <u>12</u> E	<u>J-13</u>
	T <u>   </u> R <u>   </u>	<u>   </u>
	T <u>   </u> R <u>   </u>	<u>   </u>
	T <u>   </u> R <u>   </u>	<u>   </u>
2. Property Controlling in Section	S <u>   </u> T <u>   </u> R <u>   </u>	<u>   </u>
	S <u>   </u> T <u>   </u> R <u>   </u>	<u>   </u>
3. Miscellaneous Property in Sec.	S <u>   </u> T <u>   </u> R <u>   </u>	<u>   </u>
	S <u>   </u> T <u>   </u> R <u>   </u>	<u>   </u>

STATE OF MICHIGAN  
HURON COUNTY  
RECORDED  
7 NOV 96 4:07 P.M.  
FRANCES L. HOLDWICK  
REGISTER OF DEEDS  
Register of Deeds Stamp & File Number

4. Lot No. \_\_\_\_\_, Recorded Plat \_\_\_\_\_  
5. Private Claims \_\_\_\_\_

I, Russell L. Brown, in a field survey on Oct. 8, 1996 do hereby state that under requirements of P.A. 74, Michigan P.A. of 1970, the corner points mentioned in lines 1 and 2 above were in conformance with regulations and rules therefore as required in the current manual of survey instructions of the United States Department of the Interior, Bureau of Land Management or by a decree of a Court of Law and/or that the corner points mentioned in lines 3, 4 and 5 above were in conformance with the rules of the Michigan Board of Land Surveyors or by a Decree of a Court of Law; established, re-established, monumented, recovered, found as expressed below:

NOTE: Not more than 2 corners, all in the same town and range, may be recorded on this certificate.

1	A	B	C	D	E	F	G	H	I	J	K	L	M
2		6		5		4		3		2		1	
3													
4		7		8		9		10		11		12	
5													
6		10		17		16		15		14		13	
7													
8		19		20		21		22		23		24	
9													
10		30		29		28		27		26		25	
11													
12		31		32		33		34		35		36	
13													

A. Description of original monument and accessories and/or subsequent restoration:

1830 G.L.O., H. Parke D.S.  
Set quarter Section Post  
Hemlock 22", N40°E 10 Links  
Hemlock 16", N49°W 37 Links

County Road Commission Records:  
NONE

Act 74 L.C.R.C.  
NONE

November 12, 1885, County Surveyor Records:  
Henry Strudwick County Surveyor  
No object stated or accessories given.

No surveys recorded or unrecorded found.

B. Description of corner evidence found and/or method applied in restoring or reestablishing corner.


No evidence of original corner or accessories found.

Re-established Corner position by proportionate measure from G.L.O. Notes, between I-13 and K-13 as best evidence original Corner position for J-13, corner falls in approximate centerline gravel road East and West, no occupation North.

C. Description of monument for corner and accessories established to perpetuate locating the position of the corner:

S. 1/4 Corner Section 35, T15N-R12E J-13  
Set 1/2" x 18" Steel Stake capped R.L.S. 24588, 3" to 4"+ below surface.

- WITNESSES:
- N45°W 21.84' to 1/2" x 18" Steel Stake capped RLS 24588
  - S10°W 47.64' to 1/2" x 18" Steel Stake capped RLS 24588
  - S45°E 30.41' to 1/2" x 18" Steel Stake capped RLS 24588
  - N45°E 24.35' to 1/2" x 18" Steel Stake capped RLS 24588

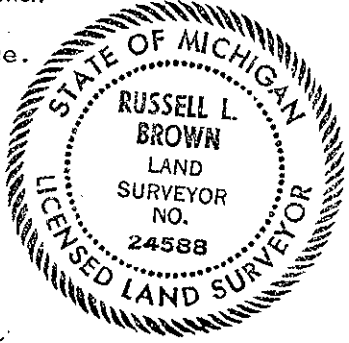

Witnessed by Russell L. Brown  
Surveyor's Michigan License No. 24588

Date 11-25-96

PEER GROUP APPROVED AT MEETING 11-05-96. [Signature]