

**SURVEY & REMONUMENTATION**

MAR 19 1997

COMMISSION 1996

*Re-Monumentation, Page 57*  
REMONUMENTATION

**LAND CORNER RECORDATION CERTIFICATE**  
Filing Requirement of Act 74, Mich. P.A. 1970

For corners in Bingham Township

Huron County (County)	Located In:	Corner Code #
1. Public Land Survey	T <u>15</u> N R <u>13</u> E	D-13
	T ___ R ___	_____
	T ___ R ___	_____
	T ___ R ___	_____
2. Property Controlling in Section	S ___ T ___ R ___	_____
	S ___ T ___ R ___	_____
3. Miscellaneous Property in Sec.	S ___ T ___ R ___	_____
	S ___ T ___ R ___	_____

STATE OF MICHIGAN  
HURON COUNTY  
RECORDED  
7 NOV 96 4:09 P.M.  
FRANCES L. HOLDWICK  
REGISTER OF DEEDS  
Register of Deeds Stamp & File Number

4. Lot No. \_\_\_\_\_, Recorded Plat \_\_\_\_\_  
5. Private Claims \_\_\_\_\_

I, Russell L. Brown, in a field survey on Oct. 8, 1996 do hereby state that under requirements of P.A. 74, Michigan P.A. of 1970, the corner points mentioned in lines 1 and 2 above were in conformance with regulations and rules therefore as required in the current manual of survey instructions of the United States Department of the Interior, Bureau of Land Management or by a decree of a Court of Law and/or that the corner points mentioned in lines 3, 4 and 5 above were in conformance with the rules of the Michigan Board of Land Surveyors or by a Decree of a Court of Law; established, re-established, monumented, recovered, found as expressed below:

	A	B	C	D	E	F	G	H	I	J	K	L	M
1													
2		6		5		4		3		2		1	
3													
4		7		8		9		10		11		12	
5													
6		18		17		16		15		14		13	
7													
8		19		20		21		22		23		24	
9													
10		30		29		28		27		26		25	
11													
12		31		32		33		34		35		36	
13													

NOTE: Not more than 2 corners, all in the same town and range, may be recorded on this certificate.

A. Description of original monument and accessories and/or subsequent restoration:

1834 G.L.O. H. Parke D.S. Set quarter Section Post Hemlock 24" N53E 29 Links Hemlock 20" N50L/2W 25 Links	County Road Commission Records 2 Pointed Stones, Iron Pin 12" tree Nail & Cap, N0° 24.75' 18" Maple, N75°E 144.38' 12" tree, S0° 67.45' 8" Birch, S70°E 104.55'
--	--

County Surveyors Record:  
NONE


(OVER)

B. Description of corner evidence found and/or method applied in restoring or reestablishing corner:

Found 1/2" Steel Stake at single proportionate measurement between C-13 and E-13, T15N-R13E  
Approximate 5.2' East of Fence North of Centerline gravel road East and West  
Raised 1/2" Steel Stake with 3/4" Pipe Capped R.L.S. 24588 to 3" ± below surface  
Accepted: Found 1/2" Steel Stake as best evidence of original position of Corner, D-13.

C. Description of monument for corner and accessories established to perpetuate locating the position of the corner:

S. 1/4 Cor. Sec. 32, T15N-R13E D-13  
1/2" Steel Stake, raised with 3/4" Pipe, capped R.L.S. 24588  
WITNESSES:  
N10°W 31.84' to Spike in E. Side Fence Corner Post  
N45°W 35.37' to Notch in E. End 24" Drive Culvert  
Found S30°W 66.38' to Spike in Easterly Side 8" Birch Tree  
Found S10°W 33.80' to Spike in East Side 20" Ash Tree  
S50°E 75.09' to Spike in Northeast Side Power Pole

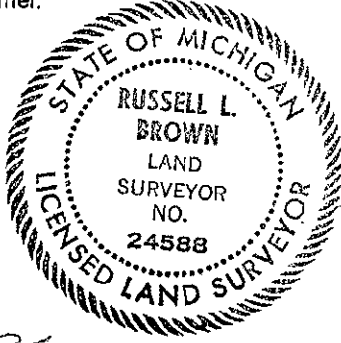

Signed by Russell L. Brown

Date 11-05-96

Surveyor's Michigan License No. 24588

PEER GROUP APPROVED  
AT MEETING 11-05-96

*Liber 1, Page 57 A*

December 7, 1972 Act 74, L.C.R.C. Liber 1, Page 2, Huron County Records.  
2 Pointed Stones, Set "T" Iron  
North 24.74' Nail & Cap 12" Tree  
South 67.45' Nail & Cap 12" Tree  
S70°E 104.55' Nail & Cap 8" Birch Tree

September 20, 1971 Survey by Rowe Engineering (C-0371-71). Same monument  
and accessories as Act 74 L.C.R.C. Liber 1, Page 2, Huron County Records.  
ALSO  
N75°E 144.38' to Nail & Cap in 18" Maple Tree

September 25, 1992 Survey by Huron Surveying (Project No: 92-2855).  
1/2" Re-rod  
South 68.0' to 20" Ash Tree  
S30°W 66.38' to 8" Birch Tree  
North 32.89' to Spike in Cedar Post

October 21, 1992 Survey by Huron Surveying (Project No: 92-2881).  
Same monument and accessories as September 25, 1992 Survey.

January 25, 1993 Survey by Huron Surveying (Project No: 93-2950).  
Same monument and accessories as September 25, 1992 Survey.