

**SURVEY &
REMONUMENTATION**

MAR 19 1997

COMMISSION 1996

Re-Man Liber 1, Page 58

REMONUMENTATION

**LAND CORNER RECORDATION CERTIFICATE
Filing Requirement of Act 74, Mich. P.A. 1970**

For corners in Bingham Township

<u>Huron County</u> (County)	Located In:	Corner Code #
1. Public Land Survey	T15N R13E	E-13
	T___ R___	_____
	T___ R___	_____
	T___ R___	_____
2. Property Controlling in Section	S___ T___ R___	_____
	S___ T___ R___	_____
3. Miscellaneous Property in Sec.	S___ T___ R___	_____
	S___ T___ R___	_____

STATE OF MICHIGAN
HURON COUNTY
RECORDED
7 NOV 96 4:09 P.M.
FRANCES L. KOLOWICK
REGISTER OF DEEDS
Register of Deeds Stamp & File Number

4. Lot No. _____, Recorded Plat _____
5. Private Claims _____

I, Russell L. Brown, in a field survey on Oct. 8, 1996 do hereby state that under requirements of P.A. 74, Michigan P.A. of 1970, the corner points mentioned in lines 1 and 2 above were in conformance with regulations and rules therefore as required in the current manual of survey instructions of the United States Department of the Interior, Bureau of Land Management or by a decree of a Court of Law and/or that the corner points mentioned in lines 3, 4 and 5 above were in conformance with the rules of the Michigan Board of Land Surveyors or by a Decree of a Court of Law; established, re-established, monumented, recovered, found as expressed below:

1	A	B	C	D	E	F	G	H	I	J	K	L	M
2		6		5		4		3		2		1	
3													
4		7		8		9		10		11		12	
5													
6		18		17		16		15		14		13	
7													
8		19		20		21		22		23		24	
9													
10		30		29		28		27		26		25	
11													
12		31		32		33		34		35		36	
13													

NOTE: Not more than 2 corners, all in the same town and range, may be recorded on this certificate.

A. Description of original monument and accessories and/or subsequent restoration:

1834 G.L.O., H. Parke D.S.
Set Post Corner Sections 32 and 33
11" Beech, N31W 39 Links
11" Beech, N81 1/2E 34 Links

County Road Commission Records
NONE

County Surveyors Record;
NONE

Act 74 Form
NONE

B. Description of corner evidence found and/or method applied in restoring or reestablishing corner:

Found 5/8" Steel Stake approximate centerline gravel roads East and West and North, approximate 16' West of gravel road South, 3" below surface.


Accepted: Found 5/8" Steel Stake as the best evidence of the original position of Corner E-13.

C. Description of monument for corner and accessories established to perpetuate locating the position of the corner:

Corner Sections 32 and 33, T15N-R13E E-13
Found 5/8" Steel Stake

WITNESSES:

N45°W 47.21' Found 1/2" Dia. Steel Stake capped R.L.S. 24588
S40°W 39.41' to 1/2" Dia. Steel Stake, capped R.L.S. 24588
S35°E 101.81' Found Spike in Northeast Side of Power Pole
N45°E 46.86' Found Spike in Southeast Side of Wood Corner Post

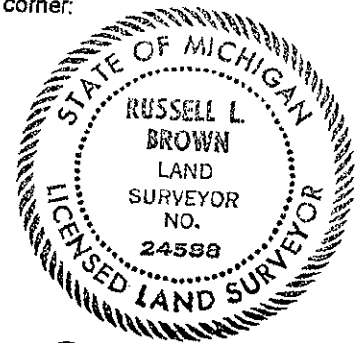

Signed by Russell L. Brown

Date 11-05-96

Surveyor's Michigan License No. 24588

PEER GROUP APPROVED

AT MEETING 11-05-96

Liber 1, Page 58 A

December 12, 1978. Survey, Liber 3 of Surveys, Page 728 of Huron County Records.
5/8" Steel Pin
Spike in Southwest Side of Power Pole, S40°W 102.20'
Center Telephone Cable Riser Box S30°W 33.30'
1/2" Steel Pin, N45°W 44.44'

October 21, 1992 Survey by Huron Surveying (Project No: 92-2881)
5/8" Steel Stake
N45°W 47.15' to 1/2" Steel Stake
N45°E 46.77' to Spike in Southeast Side Corner Post
S30°E 101.78' to Spike in Northeast Side Power Pole

January 25, 1993 Survey by Huron Surveying (Project No: 93-2950)
Same monument and accessories as October 21, 1992 survey.

Undated survey by Case Surveying (Job No. 01014)
Same Monument and accessories as survey Liber 3 of Surveys, Page 728, Huron County Records.

\$ 2.00 MSSR
\$ 9.00 SURVEY