

SURVEY & REMONUMENTATION

MAR 19 1997

Re-Monument, Page 59

COMMISSION¹⁹⁹⁶ REMONUMENTATION

LAND CORNER RECORDATION CERTIFICATE
Filing Requirement of Act 74, Mich. P.A. 1970

For corners in Bingham Township

Huron County (County)	Located in:	Corner Code #
1. Public Land Survey	T <u>15</u> N R <u>13</u> E	F-13
	T ___ R ___	___
	T ___ R ___	___
	T ___ R ___	___
2. Property Controlling in Section	S ___ T ___ R ___	___
	S ___ T ___ R ___	___
3. Miscellaneous Property in Sec.	S ___ T ___ R ___	___
	S ___ T ___ R ___	___

STATE OF MICHIGAN
HURON COUNTY
RECORDED
7 NOV 96 4:09 P.M.
FRANCES L. HOLDWICK
REGISTER OF DEEDS

Register of Deeds Stamp & File Number

4. Lot No. _____, Recorded Plat _____
5. Private Claims _____

I, Russell L. Brown, in a field survey on Oct. 8, 1996 do hereby state that under requirements of P.A. 74, Michigan P.A. of 1970, the corner points mentioned in lines 1 and 2 above were in conformance with regulations and rules therefore as required in the current manual of survey instructions of the United States Department of the Interior, Bureau of Land Management or by a decree of a Court of Law and/or that the corner points mentioned in lines 3, 4 and 5 above were in conformance with the rules of the Michigan Board of Land Surveyors or by a Decree of a Court of Law; established, re-established, monumented, recovered, found as expressed below:

NOTE: Not more than 2 corners, all in the same town and range, may be recorded on this certificate.

	A	B	C	D	E	F	G	H	I	J	K	L	M
1													
2	6		5		4		3		2		1		
3													
4	7		8		9		10		11		12		
5													
6	18		17		16		15		14		13		
7													
8	19		20		21		22		23		24		
9													
10	30		29		28		27		26		25		
11													
12	31		32		33		34		35		36		
13													

A. Description of original monument and accessories and/or subsequent restoration:


1834 G.L.O., H. Parke D.S. Set quarter Section Post Hemlock 24", N57E 29 Links Beech 7", N40°W 16 Links	County Road Commission Records: Pointed Stone, Nail, Fence Post S34E 35.38' Nail, Fence Post S14W 30.22' Nail, Fence Post N10°E 27.37' Nail, Telephone Pole N71W 72.39'
County Surveyor Records NONE	

B. Description of corner evidence found and/or method applied in restoring or reestablishing corner:

Found 1 1/2" Pipe in centerline gravel road East and West in line with fence to North, 1'± below surface
Accepted: Found 1 1/2" Pipe as the best evidence of original corner position for corner F-13.

C. Description of monument for corner and accessories established to perpetuate locating the position of the corner:

South 1/4 Corner Section 33, T15N-R13E F-13
Found 1 1/2" Pipe, raised to 4" below surface with 1/2" x 18" Steel Re-Rod capped with R.L.S. 24588
North 31.76' to Spike in East Side Fence Corner Post
N45°W 49.34' to 1/2" Dia. Steel Stake Capped R.L.S. 24588
S55°W 40.39' to 1/2" Dia. Steel Stake Capped R.L.S. 24588
S30°E 39.54' to Spike in Southwest Side Fence Corner Post

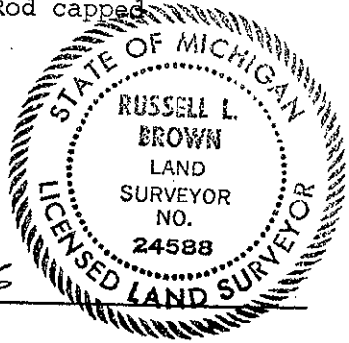

Signed by Russell L. Brown
Surveyor's Michigan License No. 24588

Date 11-05-96

PEER GROUP APPROVED
AT MEETING 11-05-96
[Signature]

Liber 1, Page 59A

Survey: Liber 1, Page 486, Huron County Records
Found 1 1/2" Iron Pipe
Spike in West Side of Corner Fence Post, North 31.58'
Spike in Northeast Side Corner Fence Post, S20°E 39.25'
Steel Fence Post N50°E, 47.51'

\$ 9.00 SURVEY
\$ 2.00 MSSR