

SURVEY & REMONUMENTATION

MAR 19 1997

COMMISSION

1996 REMONUMENTATION

Re-Mon Liber 1, Page 66

LAND CORNER RECORDATION CERTIFICATE
Filing Requirement of Act 74, Mich. P.A. 1970

For corners in Bingham Township

<u>Huron County</u> (County)	Located In:	Corner Code #
1. Public Land Survey	T15N R13E	M-13 ✓
	T15N R14E	A-13
	T14N R13E	M-01
	T14N R14E	A-01
2. Property Controlling in Section	S ___ T ___ R ___	___
	S ___ T ___ R ___	___
3. Miscellaneous Property in Sec.	S ___ T ___ R ___	___
	S ___ T ___ R ___	___

STATE OF MICHIGAN
HURON COUNTY
RECORDED
7 NOV 96 4:10 P.M.
FRANCES L. HOLDWICK
REGISTER OF DEEDS
Register of Deeds Stamp & File Number

4. Lot No. _____, Recorded Plat _____
5. Private Claims _____

I, Russell L. Brown, in a field survey on Oct. 7, 19 96 do hereby state that under requirements of P.A. 74, Michigan P.A. of 1970, the corner points mentioned in lines 1 and 2 above were in conformance with regulations and rules therefore as required in the current manual of survey instructions of the United States Department of the Interior, Bureau of Land Management or by a decree of a Court of Law and/or that the corner points mentioned in lines 3, 4 and 5 above were in conformance with the rules of the Michigan Board of Land Surveyors or by a Decree of a Court of Law, established, re-established, monumented, recovered, found as expressed below:

NOTE: Not more than 2 corners, all in the same town and range, may be recorded on this certificate.

	A	B	C	D	E	F	G	H	I	J	K	L	M
1													
2	6		5		4		3		2		1		
3													
4	7		8		9		10		11		12		
5													
6	18		17		16		15		14		13		
7													
8	19		20		21		22		23		24		
9													
10	30		29		28		27		26		25		
11													
12	31		32		33		34		35		36		
13													

A. Description of original monument and accessories and/or subsequent restoration:

1834 G.L.O., H. Parke D.S.
Intersected Range Line, Set Post at 81.06 Chains
Beech 11", S11°W 14 Links
DO 16", N23 1/2°E 31 1/2 Links

1883 County Surveyor:
In survey records for Section 36,
T15N-R13E, Duncan McFadder referred
to Southeast Corner Section 36 as an
established Post. No Witnesses.

Act 74 Form: Liber 1, Re-Mon, Page 15 Huron County Records.

Found 1/2" Iron Bar in Gravel Road Bed
WITNESSES:
(OVER)

B. Description of corner evidence found and/or method applied in restoring or reestablishing corner:


Southeast Corner Section 36, T15N-R13E; Found 1/2" Iron Bar in centerline of gravel road.
(Intersection of Huron Line and Verona Road)
Recovered 2 witnesses that indicate 1/2" Iron Bar to be same position as 1973 recorded survey and 1995 unrecorded survey.

Accepted: Found 1/2" Iron Bar as the best evidence of original position of corner M-13.

C. Description of monument for corner and accessories established to perpetuate locating the position of the corner:

S.E. Corner Section 36, T15N-R13E M-13
Found 1/2" Iron Bar in gravel road bed
WITNESSES:
N45°E 70.75' to P.K. Nail in Southeast Side of Anchor Pole
S45°E 44.05' to P.K. Nail in Northeast Side of Power Pole
N45°W 72.47' to Nail in Northeast Side of Power Pole
S45°W 49.80' to Nail in Southeast Side of Anchor Pole
East 2716.65' to South 1/4 Corner Section 31, T15N-R14E

NOTE: This Corner is common with A-13, T15N-R14E, M-1, T14N-R13E, and A-1, T14N-R14E.

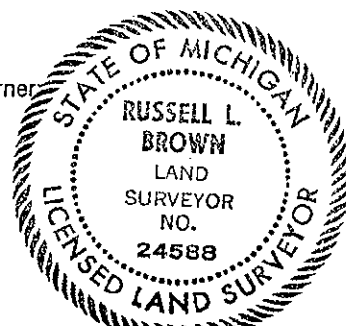

Signed by Russell L. Brown
Surveyor's Michigan License No. 24588

Date 11-05-96

PEER GROUP APPROVED
AT MEETING 11-05-96 *[Signatures]*

N45°E 70.75' to Nail in S.E. Side of Anchor Pole
S45°E 44.05' to Nail in N.E. Side of Power Pole
N45°W 72.47' to Nail in N.E. Side of Power Pole
S45°W 49.80' to Nail in S.E. Side of Anchor Pole
East 2716.65' to S. 1/4 Cor. Sec. 31, T15N-R14E

*Liber 1,
Page 66 A*

County Road Commission Records:
3/4" Steel Pin in Nest of Stones
Face anchor Post, N45°E 69.30'
Face Power Pole, S45°E 43.90'

August 30, 1995 Unrecorded Survey by Huron Surveying
Found 5/8" Iron Bar, raised with 1/2" Steel Stake
N20°E 70.75' to P.K. Nail in Northeast Side Power Pole
N20°W 72.46' to P.K. Nail in East Side Power Pole
S45°E 44.09' to Nail in North Side Power Pole
S45°W 49.75' to Nail in North Side Power Pole

May 16, 1973; Survey recorded in Liber 1 of Surveys, Page 485 of Huron County Records
Found 3/4" Steel Pin
Spike in Northeast Side Power Pole, N20°W 67.10'
Spike in Northwest Side Anchor Pole, S50°W 49.75'
Spike in Northeast Side Power Pole, S40°E 44.05'

\$ 2.00 MSSR
\$ 9.00 SURVEY