

**SURVEY &  
REMONUMENTATION**

OCT 29 1996

COMMISSION

*Re-Monumented, Page 18*

REMONUMENTATION

**LAND CORNER RECORDATION CERTIFICATE  
Filing Requirement of Act 74, Mich. P.A. 1970**

For corners in

<u>Huron</u> (County)	Located In:	Corner Code #
1. Public Land Survey	Paris T15N R14E	G-13, H-13
	T___ R___	_____
	T___ R___	_____
	T___ R___	_____
2. Property Controlling in Section	S___ T___ R___	_____
	S___ T___ R___	_____
3. Miscellaneous Property in Sec.	S___ T___ R___	_____
	S___ T___ R___	_____

STATE OF MICHIGAN  
HURON COUNTY  
RECORDED  
10 SEP 96 8:42 A.M.  
FRANCES L. HOLDWICK  
REGISTER OF DEEDS  
Register of Deeds Stamp & File Number

4. Lot No. \_\_\_\_\_, Recorded Plat \_\_\_\_\_  
5. Private Claims \_\_\_\_\_

I, Charles S. Getz, in a field survey on July 2, 1996 do hereby state that under requirements of P.A. 74, Michigan P.A. of 1970, the corner points mentioned in lines 1 and 2 above were in conformance with regulations and rules therefore as required in the current manual of survey instructions of the United States Department of the Interior, Bureau of Land Management or by a decree of a Court of Law and for that the corner points mentioned in lines 3, 4 and 5 above were in conformance with the rules of the Michigan Board of Land Surveyors or by a Decree of a Court of Law; established, re-established, monumented, recovered, found as expressed below:

NOTE: Not more than 2 corners, all in the same town and range, may be recorded on this certificate.

A	B	C	D	E	F	G	H	I	J	K	L	M
1												
2	6	5	4	3	2	1						
3												
4	7	8	9	10	11	12						
5												
6	19	17	16	15	14	13						
7												
8	19	20	21	22	23	24						
9												
10	30	29	28	27	26	25						
11												
12	31	32	33	34	35	36						
13												

A. Description of original monument and accessories and/or subsequent restoration:

- G-13 GLO Notes  
Set Post at 80.00 chains  
Beech 13", N53-1/2°E, 46 Links  
Do. 11", N13°W, 33 1/2 Links  
County Surveyor's Record - Iron Rod,  
Act 74 - None, Act 132 - None
- H-13 GLO Notes  
Set 1/4 Post at 40.00 Chains  
Hemlock 11", N51-1/2°W, 11 Links  
Cedar 7", N30°E, 14 Links  
County Surveyor's Record - Iron Pin over Stone  
Act 74 - None, Act 132 - None


B. Description of corner evidence found and/or method applied in restoring or reestablishing corner:

- G-13  
SW Cor, Section 34, T15N-R14E  
Found 1/2" Iron Bar in Gravel Road  
(Intersection of Huron Line Road and Polk Road)  
APPROVED PEER BOARD MEETING  
RLB Sept 9, 1996
- H-13  
S 1/4 Cor, Section 34, T15N-R14E  
Found 5/8" Iron Bar in Gravel Road Bed (Huron Line Road), 2' below Road surface.  
Raised with 1/2" Iron Bar.

C. Description of monument for corner and accessories established to perpetuate locating the position of the corner.

- |  |   |
|--|---|
| G-13<br>SW Cor, Section 34, T15N-R14E<br>1/2" Iron Bar in Gravel Road Bed<br>N45°E 60.85' to Nail in SE Side of Power Pole<br>S45°E 42.90' to Telephone Box<br>N45°W 40.85' to Stop Sign<br>S15°E 136.00' to Nail in W. Side of Power Pole<br>West 2651.36' to S 1/4 Cor, Sec 33, T15N-R14E<br>East 2640.76' to S 1/4 Cor, Sec 34, T15N-R14E | H-13<br>S 1/4 Cor, Section 34, T15N-R14E<br>1/2" Iron Bar in Gravel Road Bed<br>S15°E 44.06' to Nail in W. Side of 12" Poplar<br>S45°E 38.20' to West End of 24" C.M.P.<br>S60°E 56.40' to East End of 24" C.M.P.<br>West 2640.76' to SW Cor, Sec 34, T15N-R14E<br>East 2638.76' to SE Cor, Sec 34, T15N-R14E |
|--|---|

Signed by Charles S. Getz Date July 15, 1996  
Surveyor's Michigan License No. 25843

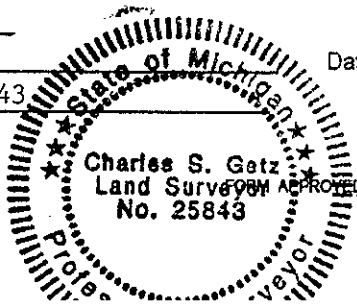

APPROVED BY MICHIGAN STATE BOARD OF PROFESSIONAL SURVEYORS, JAN. 28, 1971  
REVISED MAY 14, 1975  
REVISED JAN., 1983  
REVISED OCT., 1995