

SURVEY & REMONUMENTATION

OCT 28 1996

COMMISSION

Re-Mon Liber 1, Page 17

REMONUMENTATION

LAND CORNER RECORDATION CERTIFICATE
Filing Requirement of Act 74, Mich. P.A. 1970

For corners in

<u>Huron</u> (County)	Located in:	Corner Code #
1. Public Land Survey	Paris T15N R14E	<u>K-13</u> , L-13
	T___ R___	_____
	T___ R___	_____
	T___ R___	_____
2. Property Controlling in Section	S___ T___	_____
	S___ T___	_____
3. Miscellaneous Property in Sec.	S___ T___	_____
	S___ T___	_____

STATE OF MICHIGAN
HURON COUNTY
RECORDED

10 SEP 96 8:42 A.M.

FRANCES L. HOLDWICK
REGISTER OF DEEDS

Register of Deeds Stamp & File Number

4. Lot No. _____, Recorded Plat _____
5. Private Claims _____

I, Charles S. Getz, in a field survey on July 2, 19 96 do hereby state that under requirements of P.A. 74, Michigan P.A. of 1970, the corner points mentioned in lines 1 and 2 above were in conformance with regulations and rules therefore as required in the current manual of survey instructions of the United States Department of the Interior, Bureau of Land Management or by a decree of a Court of Law and/or that the corner points mentioned in lines 3, 4 and 5 above were in conformance with the rules of the Michigan Board of Land Surveyors or by a Decree of a Court of Law; established, re-established, monumented, recovered, found as expressed below:

NOTE: Not more than 2 corners, all in the same town and range, may be recorded on this certificate.

1	A	B	C	D	E	F	G	H	I	J	K	L	M
2		6		5		4		3		2		1	
3													
4		7		8		9		10		11		12	
5													
6		10		17		16		15		14		13	
7													
8		19		20		21		22		23		24	
9													
10		30		29		28		27		26		25	
11													
12		31		32		33		34		35		36	
13													

A. Description of original monument and accessories and/or subsequent restoration:

K-13 GLO Notes
Set Post at 80.00 Chains
Sugar 16", N25°W, 5 Links
Aspin 15", N49°E, 2 1/2 Links

County Surveyor's Record - 5/8" Steel Pin,
Act 74 - None, Act 132 - Liber 1, Page 405,
Unrecorded Survey dated 5-23-95 by Case
Surveying

L-13 GLO Notes
Set 1/4 Post at 40.00 Chains
Beech 6", N68°W, 16 Links
Do. 6", N36°E, 11 Links

County Surveyor's Record - Iron Pin in Post,
Act 74 - None, Act 132 - None

B. Description of corner evidence found and/or method applied in restoring or reestablishing corner:

K-13
SW Cor, Section 36, T15N-R14E
Found 1/2" Iron Bar, 1' below Road Surface, in
Centerline of Gravel Road (Intersection of Huron
Line Road and Minden Road to North), 33.95' East
of 1/2" Iron Bar in $\frac{1}{2}$ of Huron Line Road & Minden Road to South

APPROVED PEER BOARD MEETING
RLB Sept 7, 1996

L-13
S 1/4 Cor, Section 36, T15N-R14E
Found 5/8" Iron Bar in Gravel Road (Huron Line Road)


C. Description of monument for corner and accessories established to perpetuate locating the position of the corner:

K-13
SW Cor, Section 36, T15N-R14E
1/2" Iron Bar in Gravel Road Bed
West 33.95' to 1/2" Iron Bar in Gravel Road Bed
S05°W 55.90' to West Leg of Road Sign
N45°W 48.41' to East Leg of Road Sign
N60°W 55.10' to North End of 48" C.M.P.
West 2610.50' to S 1/4 Cor, Sec 35, T15N-R14E
East 2673.83' to S 1/4 Cor, Sec 36, T15N-R14E

L-13
S 1/4 Cor, Section 36, T15N-R14E
5/8" Iron Bar in Gravel Road Bed
N10°E 38.75' to PK Nail in E. Side of
Power Pole
East 74.30' to $\frac{1}{2}$ of Railroad Track
S70°E 54.90' to Railroad Sign
N75°E 96.84' to Railroad Sign
West 2673.83' to SW Cor, Sec 36, T15N-R14E
East 2636.96' to SE Cor, Sec 36, T15N-R14E

Signed by Charles S. Getz
Surveyor's Michigan License No. 25843

Date July 15, 1996

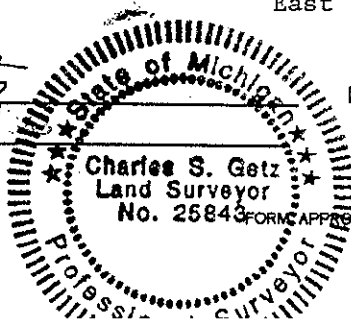

FORM APPROVED BY MICHIGAN STATE BOARD OF PROFESSIONAL SURVEYORS, JAN. 28, 1971

REVISED MAY 14, 1975
REVISED JAN., 1983
REVISED OCT., 1985