SURVEY &
REMONUMENTATION

DEC 1 6 1996

COMMISSION

Re-Mon Liber 1, Page 40

LAND CORNER RECORDATION CERTIFICATE
Filing Requirement of Act 74, Mich. P.A. 1970

For corners in

HURON (County)

	Located In:	Corner Code #
1. Public Land Survey	T15N R14E	M-13
	T___ R___	
	T___ R___	
	T___ R___	
2. Property Controlling in Section	S___ T___ R___	
	S___ T___ R___	
3. Miscellaneous Property in Sec.	S___ T___ R___	
	S___ T___ R___	

STATE OF MICHIGAN
HURON COUNTY
RECORDED

7 NOV 96 1:56 P.M.

FRANCES L. HOLDWICK
REGISTER OF DEEDS

Register of Deeds Stamp & File Number

4. Lot No. _____ , Recorded Plat _____
5. Private Claims _____

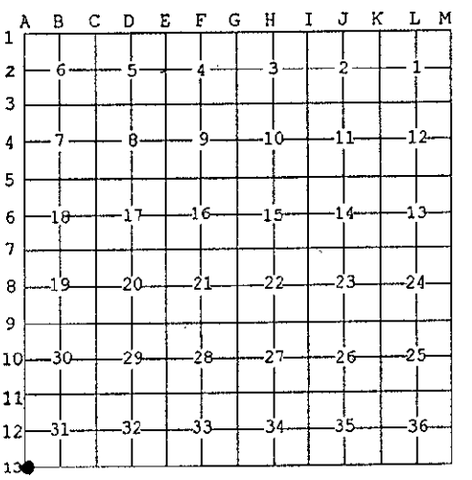

I, John A Milletics, in a field survey on Sept 17, 19 96 do hereby state that under requirements of P.A. 74, Michigan P.A. of 1970, the corner points mentioned in lines 1 and 2 above were in conformance with regulations and rules therefore as required in the current manual of survey instructions of the United States Department of the Interior, Bureau of Land Management or by a decree of a Court of Law and /or that the corner points mentioned in lines 3, 4 and 5 above were in conformance with the rules of the Michigan Board of Land Surveyors or by a Decree of a Court of Law; established, re-established, monumented, recovered, found as expressed below:

NOTE: Not more than 2 corners, all in the same town and range, may be recorded on this certificate.

A. Description of original monument and accessories and/or subsequent restoration:

M-13 GLO Notes
Birch 10 S37°W 13
Birch 17 N11½°E

Act 132 None
Act 74 Certificate recorded in Sherman Twp.
Huron County Road Notes call for iron pin

B. Description of corner evidence found and/or method applied in restoring or reestablishing corner:

A-13
SE Corner Section 36 T15N-R14E
Found 1½" Iron Pipe in gravel road bed.

APPROVED PEER BOARD MEETING
OCT 29, 1996
D.C. CSL

C. Description of monument for corner and accessories established to perpetuate locating the position of the corner:

A-13
SE Corner Section 36 T15N-R14E
1½" Iron Pipe
N45°W 72.75' to a nail in a Power Pole
N45°E 61.20' to a nail in a Power Pole
S45°E 40.75' to a nail in a Old Corner Post
N50°E 46.80' to top center of a Telephone Box
North 2629.00 to E 1/4 Cor.

State of Michigan
John A. Milletics
Land Surveyor
No. 25859
Professional Surveyor

Signed by John A Milletics

Date Oct 25, 1996

Surveyor's Michigan License No. 25859

FORM APPROVED BY MICHIGAN STATE BOARD OF PROFESSIONAL SURVEYORS, JAN. 28, 1971
REVISED MAY 14, 1975
REVISED JAN., 1983
REVISED OCT., 1995