LAND CORNER RECORDATION CERTIFICATE Filing Requirement of Act 74, Mich. P.A. 1970

 COTORTS	:


	Huron (County)	_ Located In:	Corner Code ≠#
1.	Public Land Survey	T15N R 14E	E-1 E-2
		T R	
		T R	
2.	Property Controlling	S T . R	
	in Section	S T R	
3.	Miscellaneous	S T _ R	
	Property in Sec.	S R	


Register of Deeds Stamp & File Number

- ___. , Recorded Plat_
- 5. Private Claims _____

Donald L.Bissell in a field survey on January do hereby certify that under requirements of P.A. 74, Michigan P.A. of 1970, the corner points mentioned in lines 1 and 2 above were in conformance with regulations and rules therefore as required in the current manual of survey instructions of the United States Department of the Interior, Bureau of Land Management or by a decree of a Court of Law and/or that the corner points mentioned in lines 3, 4 and 5 above were in conformance with the rules of the Michigan Board of Land Surveyors or by a Decree of a Court of Law; established, re-established, monumented, re-monumented, recovered, found as

NOTE: Not more than 4 corners, all in the same town and range, may be recorded on this certificate.

 

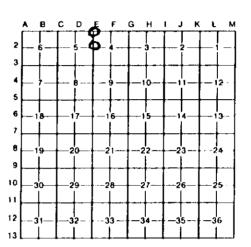

B. Description of corner evidence found and/or method applied in restoring or reestablishing corner:

NW Cor. Sec., 4, T15N, R14E FD. 1/2" iron rod in Helena Road

and MacDonald Road South.

E-2

W 1/4 Gor. Sec. 4, T15N, R14E Fd. 3/4" iron bar 30" below road,

 $N20^{\circ}E - 175.51' = Power Pole at Bend$

S48°E - 36.0' - N end 12" C.M.P. S22°E - 58.9' - S end 12" C.M.P.

The Line of the

North 184' - Centerline drive west

placed 1/2" re-rod above bar.

C. Description of monument for corner and accessories established to perpetuate locating the position of the corner:

E-1

 $N35^{\circ}W - 104.14' - 12''$ E1m

N56°E - 102.18' - 10" Elm N70°E - 118.87' - Maple Clump

S33°E - 46.4' - E end 72" C.M.P. S37°W - 41.4' - W end 72" C.M.P. East - 20.48' - 1/2" iron rod

SW Cor. Sec. 33

Signed by

Surveyor's Michigan License No. _

REVISED JAN., 1983

PAGE 24