

**SURVEY & REMONUMENTATION**

APR 27 1995

*Re-Mon. Liber 1, Page 3*

**REMONUMENTATION COMMISSION**

**LAND CORNER RECORDATION CERTIFICATE**  
Filing Requirement of Act 74, Mich. P.A. 1970

For corners in

Huron

(County)

Located in:

Corner Code ##

- |                                    |                             |                 |
|------------------------------------|-----------------------------|-----------------|
| 1. Public Land Survey              | T <u>15</u> N R <u>15</u> E | A-5, <u>A-6</u> |
|                                    | T _____ R _____             | _____           |
|                                    | T _____ R _____             | _____           |
|                                    | T _____ R _____             | _____           |
| 2. Property Controlling in Section | S _____ T _____ R _____     | _____           |
|                                    | S _____ T _____ R _____     | _____           |
| 3. Miscellaneous Property in Sec.  | S _____ T _____ R _____     | _____           |
|                                    | S _____ T _____ R _____     | _____           |

STATE OF MICHIGAN  
HURON COUNTY  
RECORDED

1 NOV 94 3:45 P.M.

FRANCES L. HOLDWICK  
REGISTER OF DEEDS

Register of Deeds Stamp & File Number

4. Lot No. \_\_\_\_\_, Recorded Plat \_\_\_\_\_
5. Private Claims \_\_\_\_\_

	A	B	C	D	E	F	G	H	I	J	K	L	M
2	6		5		4		3		2				
3													
4	7		8		9		10		11		12		
5													
6	18		17		16		15		14		13		
7													
8	19		20		21		22		23		24		
9													
10	30		29		28		27		26		25		
11													
12	31		32		33		34		35		36		
13													

I, Charles S. Getz, in a field survey on August 19, 19 94, do hereby certify that under requirements of P.A. 74, Michigan P.A. of 1970, the corner points mentioned in lines 1 and 2 above were in conformance with regulations and rules therefore as required in the current manual of survey instructions of the United States Department of the Interior, Bureau of Land Management or by a decree of a Court of Law and/or that the corner points mentioned in lines 3, 4 and 5 above were in conformance with the rules of the Michigan Board of Land Surveyors or by a Decree of a Court of Law; established, re-established, monumented, re-monumented, recovered, found as expressed below:

**NOTE: Not more than 4 corners, all in the same town and range, may be recorded on this certificate.**

**A. Description of original monument and accessories and/or subsequent restoration:**

A-5 Found 3/4" Iron Bar in Gravel Road Bed at Intersection of Priemer Road and Finkle Road as per Huron County Road Commission notes. Raised with 1/2" Iron Bar.


A-6 Found No Evidence of an Existing Corner at site. GLO Notes were researched. Huron County Road Commission notes & County Surveyor records show no evidence of Corner.

Approved at Peer Board Meeting,  
1994 10-10-94  
*Russell L. Brown*

**B. Description of corner evidence found and/or method applied in restoring or reestablishing corner:**

A-5  
NW Cor, Section 18, T15N-R15E  
Found 3/4" Iron Bar

A-6  
W 1/4 Cor, Section 18, T15N-R15E  
Set 1/2" Iron Bar on straight line at half distance between NW Cor, Section 18, T15N-R15E and SW Cor, Section 18, T15N-R15E.

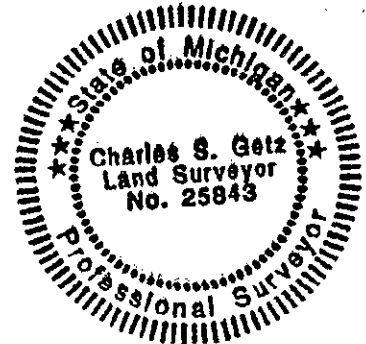

**C. Description of monument for corner and accessories established to perpetuate locating the position of the corner:**

A-5  
NW Cor, Section 18, T15N-R15E  
1/2" Iron Bar  
East 11.0' to Centerline of Gravel Road  
S45°W 37.50' to Notch in South End of 96" CMP  
N45°W 42.00' to Notch in North End of 96" CMP  
S45°E 42.00' to Notch in South End of 18" CMP  
N45°E 49.30' to Notch in North End of 18" CMP  
North 2635.29' to W 1/4 Cor, Section 7, T15N-R15E  
South 2634.80' to W 1/4 Cor, Section 18, T15N-R15E

A-6  
W 1/4 Cor, Section 18, T15N-R15E  
1/2" Iron Bar  
East 33.00' to 1/2" Iron Bar (Reference Iron)  
West 33.00' to 1/2" Iron Bar (Reference Iron)  
North 2634.80' to NW Cor, Section 18, T15N-R15E  
South 2634.80' to SW Cor, Section 18, T15N-R15E

Signed by Charles S. Getz  
Surveyor's Michigan License No. 25843

Date August 30, 1994