

**SURVEY & REMONUMENTATION**

APR 27 1995

*Re-Mon. Liber 1, Page 4*

REMONUMENTATION COMMISSION

**LAND CORNER RECORDATION CERTIFICATE**  
Filing Requirement of Act 74, Mich. P.A. 1970

For corners in

Huron  
(County)

Located In:

Corner Code #/

|                                    |   |           |   |   |           |   |                 |
|------------------------------------|---|-----------|---|---|-----------|---|-----------------|
| 1. Public Land Survey              | T | <u>15</u> | N | R | <u>15</u> | E | A-7, <u>A-8</u> |
|                                    | T |           | R |   |           |   |                 |
|                                    | T |           | R |   |           |   |                 |
|                                    | T |           | R |   |           |   |                 |
| 2. Property Controlling in Section | S |           | T | R |           |   |                 |
|                                    | S |           | T | R |           |   |                 |
| 3. Miscellaneous Property in Sec.  | S |           | T | R |           |   |                 |
|                                    | S |           | T | R |           |   |                 |

STATE OF MICHIGAN  
HURON COUNTY  
RECORDED

1 NOV 94 3:46 P.M.

FRANCES L. HOLDWICK  
REGISTER OF DEEDS

Register of Deeds Stamp & File Number

4. Lot No. \_\_\_\_\_, Recorded Plat \_\_\_\_\_  
5. Private Claims \_\_\_\_\_

|    | A  | B | C  | D | E  | F | G  | H | I  | J | K  | L | M |
|----|----|---|----|---|----|---|----|---|----|---|----|---|---|
| 2  | 6  |   | 5  |   | 4  |   | 3  |   | 2  |   | 1  |   |   |
| 3  |    |   |    |   |    |   |    |   |    |   |    |   |   |
| 4  | 7  |   | 8  |   | 9  |   | 10 |   | 11 |   | 12 |   |   |
| 5  |    |   |    |   |    |   |    |   |    |   |    |   |   |
| 6  | 18 |   | 17 |   | 16 |   | 15 |   | 14 |   | 13 |   |   |
| 7  |    |   |    |   |    |   |    |   |    |   |    |   |   |
| 8  | 19 |   | 20 |   | 21 |   | 22 |   | 23 |   | 24 |   |   |
| 9  |    |   |    |   |    |   |    |   |    |   |    |   |   |
| 10 | 30 |   | 29 |   | 28 |   | 27 |   | 26 |   | 25 |   |   |
| 11 |    |   |    |   |    |   |    |   |    |   |    |   |   |
| 12 | 31 |   | 32 |   | 33 |   | 34 |   | 35 |   | 36 |   |   |
| 13 |    |   |    |   |    |   |    |   |    |   |    |   |   |

I, Charles S. Getz, in a field survey on August 20, 19 94, do hereby certify that under requirements of P.A. 74, Michigan P.A. of 1970, the corner points mentioned in lines 1 and 2 above were in conformance with regulations and rules therefore as required in the current manual of survey instructions of the United States Department of the Interior, Bureau of Land Management or by a decree of a Court of Law and/or that the corner points mentioned in lines 3, 4 and 5 above were in conformance with the rules of the Michigan Board of Land Surveyors or by a Decree of a Court of Law; established, re-established, monumented, re-monumented, recovered, found as expressed below:

**NOTE: Not more than 4 corners, all in the same town and range, may be recorded on this certificate.**

**A. Description of original monument and accessories and/or subsequent restoration:**

- A-7 Found 3/4" Iron Bar in Gravel Road Bed at Intersection of Leppak Road and Finkle Road as per Huron County Road Commission notes.
- A-8 Found 5/8" Iron Pipe in Gravel Road Bed (Finkle Road). Huron County Road Commission notes call for "Iron Pin In Line With Fence E & W". Old Concrete Pillars are opposite 5/8" Iron Pipe, both on the East and on the West.


Approved at Peer Board Meeting,

1994 10-10-94  
*Russell L. Brown*

**B. Description of corner evidence found and/or method applied in restoring or reestablishing corner:**

A-7  
NW Cor, Section 19, T15N-R15E  
Found 3/4" Iron Bar

A-8  
W 1/4 Cor, Sec 19, T15N-R15E  
Found 5/8" Iron Pipe

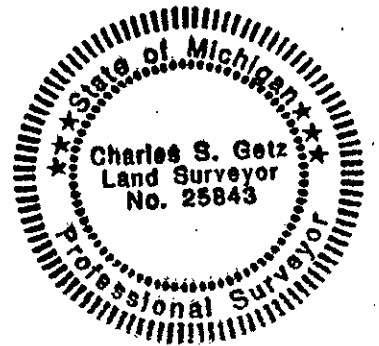

**C. Description of monument for corner and accessories established to perpetuate locating the position of the corner:**

A-7  
NW Cor, Section 19, T15N-R15E  
3/4" Iron Bar  
N45°E 47.50' to Southwest Cor of Concrete Pillar  
N45°W 41.80' to Spike in Wood Corner Post  
S45°E 60.50' to Spike in 6" Maple Tree  
S30°E 93.00' to Spike in 12" Maple Tree  
North 2634.80' to W 1/4 Cor, Section 18, T15N-R15E  
South 2656.08' to W 1/4 Cor, Section 19, T15N-R15E

A-8  
W 1/4 Cor, Section 19, T15N-R15E  
5/8" Iron Pipe  
N85°E 38.00' to Spike in Multi-Trunk Ash Tree  
East 33.50' to W. Face of Concrete Pillar  
West 32.00' to E. Face of Concrete Pillar  
N60°W 44.50' to Spike in Wood Post  
North 2656.08' to NW Cor, Section 19, T15N-R15E  
South 2644.86' to SW Cor, Section 19, T15N-R15E

Signed by Charles S. Getz

Date August 31, 1994

Surveyor's Michigan License No. 25843