

**SURVEY & REMONUMENTATION**

APR 27 1995

**LAND CORNER RECORDATION CERTIFICATE**  
Filing Requirement of Act 74, Mich. P.A. 1970

*Re-Mon. Liber 1, Page 6*

REMONUMENTATION COMMISSION

For corners in

|   |                             |                   |
|---|-----------------------------|-------------------|
| <u>Huron</u><br><small>(County)</small> | Located In:                 | Corner Code #     |
| 1. Public Land Survey                   | T <u>15</u> N R <u>15</u> E | <u>A-11, A-12</u> |
|   | T _____ R _____             | _____             |
|   | T _____ R _____             | _____             |
|   | T _____ R _____             | _____             |
| 2. Property Controlling in Section      | S _____ T _____ R _____     | _____             |
|   | S _____ T _____ R _____     | _____             |
| 3. Miscellaneous Property in Sec.       | S _____ T _____ R _____     | _____             |
|   | S _____ T _____ R _____     | _____             |
| 4. Lot No. _____, Recorded Plat _____   |                             |                   |
| 5. Private Claims _____                 |                             |                   |

STATE OF MICHIGAN  
HURON COUNTY  
RECORDED

1 NOV 94 3:46 P.M.

FRANCES L. HOLDWICK  
REGISTER OF DEEDS

Register of Deeds Stamp & File Number

I, Charles S. Getz, in a field survey on August 20, 19 94, do hereby certify that under requirements of P.A. 74, Michigan P.A. of 1970, the corner points mentioned in lines 1 and 2 above were in conformance with regulations and rules therefore as required in the current manual of survey instructions of the United States Department of the Interior, Bureau of Land Management or by a decree of a Court of Law and/or that the corner points mentioned in lines 3, 4 and 5 above were in conformance with the rules of the Michigan Board of Land Surveyors or by a Decree of a Court of Law; established, re-established, monumented, re-monumented, recovered, found as expressed below:

**NOTE: Not more than 4 corners, all in the same town and range, may be recorded on this certificate.**

**A. Description of original monument and accessories and/or subsequent restoration:**

A-11 Found 3/4" Iron Bar in Gravel Road Bed at Intersection of Munford Road and Finkle Road. Raised with 1/2" Iron Bar. Two Witnesses to Corner are as per previous survey dated 12-28-87, by Huron Surveying, Inc.

A-12 Found 3/4" Iron Bar in Gravel Road Bed (Finkle Road). Huron County Road Commission notes call for "Iron In Line W/Fence East". An Old Concrete Pillar is opposite the 3/4" Iron Bar, to the East.

**B. Description of corner evidence found and/or method applied in restoring or reestablishing corner:**

A-11  
NW Cor, Section 31, T15N-R15E  
Found 3/4" Iron Bar

A-12  
W 1/4 Cor, Section 31, T15N-R15E  
Found 3/4" Iron Bar

**C. Description of monument for corner and accessories established to perpetuate locating the position of the corner:**


A-11  
NW Cor, Section 31, T15N-R15E  
1/2" Iron Bar  
N45°W 74.75' to Spike in Northeast Side of Power Pole  
S45°W 51.00' to Notch in West End of 36" CMP  
N45°W 45.50' to Top Center of Telephone Box  
S45°E 45.82' to Notch in East End of 36" CMP  
N45°E 45.82' to Top Center of Telephone Box  
North 2644.14' to W 1/4 Cor, Sec 30, T15N-R15E  
South 2633.45' to W 1/4 Cor, Sec 31, T15N-R15E

A-12  
W 1/4 Cor, Section 31, T15N-R15E  
3/4" Iron Bar  
East 32.10' to West Face of Concrete Pillar  
N20°W 133.90' to Spike in Power Pole  
West 33.50' to Face of Steel Fence Post  
S20°W 165.50' to Spike in Power Pole  
North 2633.45' to NW Cor, Section 31, T15N-R15E  
South 2629.00' to SW Cor, Section 31, T15N-R15E

|    |    |   |    |   |    |   |    |   |    |   |    |   |    |
|----|----|---|----|---|----|---|----|---|----|---|----|---|----|
|    | A  | B | C  | D | E  | F | G  | H | I  | J | K  | L | M  |
| 2  | 6  |   | 5  |   | 4  |   | 3  |   | 2  |   | 1  |   |    |
| 3  |    |   |    |   |    |   |    |   |    |   |    |   |    |
| 4  | 7  |   | 8  |   | 9  |   | 10 |   | 11 |   | 12 |   |    |
| 5  |    |   |    |   |    |   |    |   |    |   |    |   |    |
| 6  | 16 |   | 17 |   | 18 |   | 19 |   | 20 |   | 21 |   | 22 |
| 7  |    |   |    |   |    |   |    |   |    |   |    |   |    |
| 8  | 19 |   | 20 |   | 21 |   | 22 |   | 23 |   | 24 |   |    |
| 9  |    |   |    |   |    |   |    |   |    |   |    |   |    |
| 10 | 30 |   | 29 |   | 28 |   | 27 |   | 26 |   | 25 |   |    |
| 11 |    |   |    |   |    |   |    |   |    |   |    |   |    |
| 12 | 31 |   | 32 |   | 33 |   | 34 |   | 35 |   | 36 |   |    |
| 13 |    |   |    |   |    |   |    |   |    |   |    |   |    |

Approved at Peer Board Meeting,

1994 10-10-94  
*Russell L. Brown*

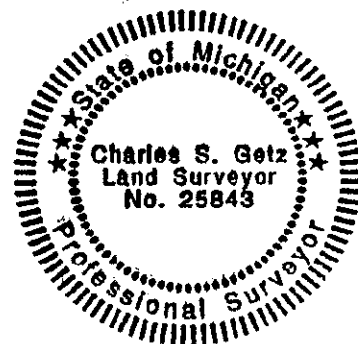

Signed by Charles S. Getz

Date September 1, 1994

Surveyor's Michigan License No. 25843