SURVEY &
REMONUMENTATION

DEC 1 6 1996

COMMISSION

Re-Mon Liber 1, Page 38

LAND CORNER RECORDATION CERTIFICATE
Filing Requirement of Act 74, Mich. P.A. 1970

For corners in

Huron
(County)

	Located In:	Corner Code #
1. Public Land Survey	T 15N R 15E	F-13 G-13
	T___ R___	
	T___ R___	
	T___ R___	
2. Property Controlling in Section	S___ T___ R___	
	S___ T___ R___	
3. Miscellaneous Property in Sec.	S___ T___ R___	
	S___ T___ R___	

STATE OF MICHIGAN
HURON COUNTY
RECORDED

7 NOV 96 1:55 P.M.

FRANCES L. HOLDWICK
REGISTER OF DEEDS

Register of Deeds Stamp & File Number

4. Lot No. _____, Recorded Plat _____
5. Private Claims _____

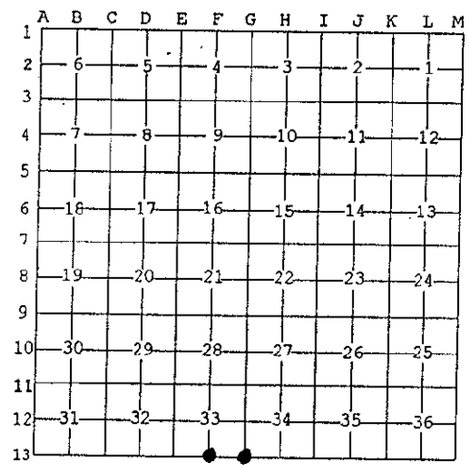

I, John A Milletics, in a field survey on 9-17, 19 96 do hereby state that under requirements of P.A. 74, Michigan P.A. of 1970, the corner points mentioned in lines 1 and 2 above were in conformance with regulations and rules therefore as required in the current manual of survey instructions of the United States Department of the Interior, Bureau of Land Management or by a decree of a Court of Law and /or that the corner points mentioned in lines 3, 4 and 5 above were in conformance with the rules of the Michigan Board of Land Surveyors or by a Decree of a Court of Law; established, re-established, monumented, recovered, found as expressed below:

NOTE: Not more than 2 corners, all in the same town and range, may be recorded on this certificate.

A. Description of original monument and accessories and/or subsequent restoration:

F-13 GLO Notes
Set 1/4 Section Post
Hemlock 7 N20W 15
Hemlock 16 N83E 18

Act 132 None Act 74 None
County Survey Records Iron Pin in Post

G-13 GLO Notes
Set Post Corner Section
Birch 11 N49W 73
Hemlock 10 N57E 11

Act 132 None Act 74 None
County Survey Record Iron Pine

B. Description of corner evidence found and/or method applied in restoring or reestablishing corner:

F-13
S 1/4 Corner 33 T15N-R15E
Found Monu Box in pavement Centerline

G-13
SE Corner Section 33 T15N-R15E
Found 3/4" Iron Bar in gravel Road Bed

APPROVED PEER BOARD MEETING
Oct 29, 1996
MSLC CSJ

C. Description of monument for corner and accessories established to perpetuate locating the position of the corner:

F-13
S 1/4 Corner Section 33 T15N-R15E
Monu Box with capped 1/2" Pin
North 33.25 to the Face of a Conc Pillar
N05°W 52.40 to a nail in a Power Pole
South 30.90 to the West end of a 18" CMP
S45°E 43.50 to the East end of a 18" CMP
West 2644.60 to SW Corner
East 2629.26 to SE Corner

G-13
SE Corner Section 33 T15N-R15E
3/4" Iron Bar
East 22.40 to a 1/2" iron bar
South 31.60 to the W. Leg of a Road Sign
S50°W 80.75 to a nail in a Anchor Pole
N45°W 76.20 to a nail in a Power Pole
West 29.90 to the East end of pavement
West 2629.26 to S 1/4 Cor.
East 2636.26 to S 1/4 Cor

Signed by John A. Milletics
Surveyor's Michigan License No. 25859
Date 10-11-96

State of Michigan
John A. Milletics
Land Surveyor
No. 25859
Professional Surveyor

FORM APPROVED BY MICHIGAN STATE BOARD OF PROFESSIONAL SURVEYORS, JAN. 26, 1971
REVISED MAY 14, 1975
REVISED JAN., 1983
REVISED OCT., 1995