

DEC 16 1996

COMMISSION

Re-Monumented, Page 37
LAND CORNER RECORDATION CERTIFICATE
 Filing Requirement of Act 74, Mich. P.A. 1970

For corners in

<u>Huron</u> (County)	Located in:	Corner Code #
1. Public Land Survey	T <u>15N</u> R <u>15E</u>	<u>H-13</u> I-13
	T ___ R ___	_____
	T ___ R ___	_____
	T ___ R ___	_____
2. Property Controlling in Section	S ___ T ___ R ___	_____
	S ___ T ___ R ___	_____
3. Miscellaneous Property in Sec.	S ___ T ___ R ___	_____
	S ___ T ___ R ___	_____

STATE OF MICHIGAN
 HURON COUNTY
 RECORDED

7 NOV 96 1:55 P.M.

FRANCES L. HOLDWICK
 REGISTER OF DEEDS

Register of Deeds Stamp & File Number

4. Lot No. _____, Recorded Plat _____
 5. Private Claims _____

I, John A. Milletics, in a field survey on 9-21, 19 96 do hereby state that under requirements of P.A. 74, Michigan P.A. of 1970, the corner points mentioned in lines 1 and 2 above were in conformance with regulations and rules therefore as required in the current manual of survey instructions of the United States Department of the Interior, Bureau of Land Management or by a decree of a Court of Law and /or that the corner points mentioned in lines 3, 4 and 5 above were in conformance with the rules of the Michigan Board of Land Surveyors or by a Decree of a Court of Law; established, re-established, monumented, recovered, found as expressed below:

NOTE: Not more than 2 corners, all in the same town and range, may be recorded on this certificate.

1	A	B	C	D	E	F	G	H	I	J	K	L	M
2		6		5		4		3		2		1	
3													
4		7		8		9		10		11		12	
5													
6		18		17		16		15		14		13	
7													
8		19		20		21		22		23		24	
9													
10		30		29		28		27		26		25	
11													
12		31		32		33		34		35		36	
13													

A. Description of original monument and accessories and/or subsequent restoration:

H-13 GLO Notes	Act 132 None, Act 74 None
Set 1/4 Section Post	No County Survey Record.
Hemlock 11 N15W 14	
Hemlock 20 N53 1/2 E 45	
I-13 GLO Notes	Act 132 None, Act 74 None
Set Post Corner	County Survey Record shows 5/8" Iron Bar
Birch 18 N11W 23	with witnesses
Hemlock 10 N53E 11	

B. Description of corner evidence found and/or method applied in restoring or reestablishing corner:


H-13	S 1/4 Corner Section 34 T15N-R15E
	Found 5/8" Iron Bar
I-13	SE Corner Section 34 T15N-R15E
	Found 5/8" Iron Bar in Gravel Road Bed

APPROVED PEER BOARD MEETING
 Oct 29, 1996

John A. Milletics

C. Description of monument for corner and accessories established to perpetuate locating the position of the corner:

H-13	I-13
S 1/4 Corner Section 34 T15N-R15E	SE Corner Section 34 T15N-R15E
5/8" Iron Bar in Gravel Road Bed	5/8" Iron Bar in Gravel Road Bed
East 23.43 to a 1/2" Iron Bar in gravel	S20°W 32.50 feet to a Bell Box
N40°E 26.80 to W Leg of Arrow sign	N45°E 71.70 to a nail in a Power Pole
S40°W 43.50 to a Bell Box	N45°W 38.60 to a Road Sign
S45°E 76.10 to a nail in a Tele Pole	S45°E 48.40 to a Stop Sign
West 2636.26' to SW Cor.	West 2636.90 to S 1/4 Cor
East 2636.90' to SE Cor	East 2636.56 to S 1/4 Cor

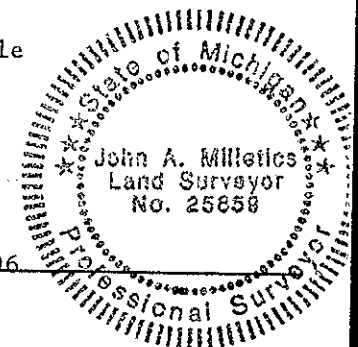

Signed by John A. Milletics
 Surveyor's Michigan License No. 25859

Date Oct 25, 1996