

**SURVEY & REMONUMENTATION**

*Re-Mon. Liber!, Page 9*

REMONUMENTATION **MARCH 7 1995**

**LAND CORNER RECORDATION CERTIFICATE**  
Filing Requirement of Act 74, Mich. P.A. 1970

**COMMISSION** For Corners in

<u>Huron</u> (County)	Located in:	Corner Code #
1. Public Land survey	Sebewaing T <u>15 N</u> R <u>9 E</u>	<u>B-13</u> <u>A-13</u>
	T _____ R _____	_____
	T _____ R _____	_____
	T _____ R _____	_____
2. Property Controlling in Section	S _____ T _____ R _____	_____
	S _____ T _____ R _____	_____
3. Miscellaneous	S _____ T _____ R _____	_____
4. Lot No. _____, Recorded Plat _____		
5. Private Claims _____		

STATE OF MICHIGAN  
HURON COUNTY  
RECORDED  
13 DEC 94 4:31 P.M.  
FRANCES L. HOLLOWICK  
REGISTER OF DEEDS  
Register of Deeds Stamp & File Number

A	B	C	D	E	F	G	H	I	J	K	L	M
2	6	5	4	3	2	1						
3												
4	7	8	9	10	11	12						
6												
6	18	17	16	15	14	13						
7												
8	18	20	21	22	23	24						
9												
10	30	29	28	27	26	25						
11												
12	31	32	33	34	35	36						
13												

I, James T. Meek, in a field survey on October, 1994, do hereby certify that under requirements of P.A. 74, Michigan P.A. of 1970, the corner points mentioned in lines 1 and 2 above were in conformance with regulations and rules thereof as required in the current manual of survey instructions of the United States Department of the Interior, Bureau of Land Management or by a decree of a Court of Law and/or that the corner points mentioned in lines 3, 4 and 5 above were in conformance with the rules of the Michigan Board of Land Surveyors or by a Decree of a Court of Law, established, re-established, monumented, re-monumented, recovered, found as

**NOTE: Not more than 4 corners, all in the same town and range, may be recorded on this certificate.**

**A. Description of original monument and accessories and/or subsequent restoration:**

Original survey, South Edy. T15N, R9E, 1835, Harvey Parke, D.S.  
**B-13:** South 1/4 Corner of Section 31, Post  
 Sugar 10", N85°W, 1/2 link  
 Ironwood 5", N81°E, 14 links  
 No County Surveyor's Record

**A-13:** Corner of Sections 31, T15NR9E & 6, T14NR9E  
 Post  
 Sugar 14", N52 1/2°E, 24 links  
 Beech 10", S50 1/2°E, 30 links  
 No County Surveyors Record

**B. Description of corner evidence found and/or method applied in restoring or reestablishing corner:**

**B-13:** South 1/4 Corner of Section 31,  
 There is no remaining evidence of the original corner position.

**A-13:** Corner of Sections 31, T15NR9E & 6, T14NR9E  
 Found 1" bolt in monument box  
 At centerline Highway M-25  
 8'± South of int. of cl Huron Line Rd. (E-W)  
 Accepted as best available evidence of original corner position.


**C. Description of monument for corner and accessories established to perpetuate localing the position of the corner:**

**B-13:** South 1/4 Corner of Section 31,  
 At proportionate distance;  
 Set 'T' iron, 18" long, 6" below grd.  
 from which:  
 1/2" iron rod, 24" long, N45°W, 29.47'  
 1 1/2" pipe, 22" long, S45°E, 8.23'  
 1 1/2" pipe, 14" long, S45°W, 8.42'  
 3/4" pipe, 22" long, N45°E, 31.40'  
 8'± South of cl Huron Line Rd.  
**A-13,** 1" bolt in monument box, N89°42'14"W, 800.17'  
**C-13,** 1/2" iron, S89°42'14"E, 2640.84'

**A-13:** Corner of Sections 31, T15NR9E & 6, T14NR9E  
 1" bolt in monument box  
 from which:  
 RP Tag in SW face of PP, N69°E, 82.45'  
 Road Sign Post, S72°E, 58.57'  
 Sign Post (M-25), S25°W, 71.13'  
 RP Tag in SE face of PP, N59°W, 55.23'  
**B-13,** T iron w/cap#39089, S89°42'14"E, 800.17'

Signed by James T. Meek  
 Surveyor's Michigan License No. 39089

Date 12-12-94

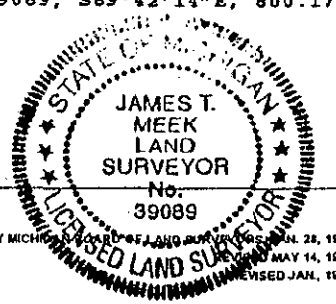

APPROVED AT PEER BOARD MEETING 12-10-94 RLB