

Re-Mon. Liber!, Page 9

SURVEY & REMONUMENTATION

LAND CORNER RECORDATION CERTIFICATE
Filing Requirement of Act 74, Mich. P.A. 1970

APR 27 1995

For Corners in Located in: Corner Code #

1. Public Land survey	Sebawaing	T 15 N R 9 E	<u>B-13</u> A-13
		T _____ R _____	
		T _____ R _____	
		T _____ R _____	
2. Property Controlling in Section	S _____	T _____ R _____	
	S _____	T _____ R _____	
3. Miscellaneous	S _____	T _____ R _____	
4. Lot No. _____, Recorded Plat _____			
5. Private Claims _____			

STATE OF MICHIGAN
HURON COUNTY
RECORDED

13 DEC 94 4:31 P.M.

FRANCES L. HOLWICK
REGISTER OF DEEDS
Register of Deeds Stamp & File Number

I, James T. Meek, in a field survey on October, 1994, do hereby certify that under requirements of P.A. 74, Michigan P.A. of 1970, the corner points mentioned in lines 1 and 2 above were in conformance with regulations and rules thereof as required in the current manual of survey instructions of the United States Department of the Interior, Bureau of Land Management or by a decree of a Court of Law and/or that the corner points mentioned in lines 3, 4 and 5 above were in conformance with the rules of the Michigan Board of Land Surveyors or by a Decree of a Court of Law, established, re-established, monumented, re-monumented, recovered, found as

A	B	C	D	E	F	G	H	I	J	K	L	M
2	6	5	4	3	2	1						
3												
4	7	8	9	10	11	12						
5												
6	18	17	16	15	14	13						
7												
8	19	20	21	22	23	24						
9												
10	30	29	28	27	26	25						
11												
12	31	32	33	34	35	36						
13												

NOTE: Not more than 4 corners, all in the same town and range, may be recorded on this certificate.

A. Description of original monument and accessories and/or subsequent restoration:

Original survey, South Bdy. T15N, R9E, 1835, Harvey Parke, D.S.

B-13: South 1/4 Corner of Section 31, Post Sugar 10", N85°W, 1/2 link Ironwood 5", N81°E, 14 links No County Surveyor's Record	A-13: Corner of Sections 31, T15NR9E & 6, T14NR9E Post Sugar 14", N52 1/2°E, 24 links Beech 10", S50 1/2°E, 30 links No County Surveyors Record
---	--

B. Description of corner evidence found and/or method applied in restoring or reestablishing corner:


B-13: South 1/4 Corner of Section 31, There is no remaining evidence of the original corner position.	A-13: Corner of Sections 31, T15NR9E & 6, T14NR9E Found 1" bolt in monument box At centerline Highway M-25 8' ± South of int. of cl Huron Line Rd. (E-W) Accepted as best available evidence of original corner position.
---	--

C. Description of monument for corner and accessories established to perpetuate locating the position of the corner:

B-13: South 1/4 Corner of Section 31, At proportionate distance; Set 'T' iron, 18" long, 6" below grd. from which: 1/2" iron rod, 24" long, N45°W, 29.47' 1 1/2" pipe, 22" long, S45°E, 8.23' 1 1/2" pipe, 14" long, S45°W, 8.42' 3/4" pipe, 22" long, N45°E, 31.40' 8' ± South of cl Huron Line Rd. A-13, 1" bolt in monument box, N89°42'14"W, 800.17' C-13, 1/2" iron, S89°42'14"E, 2640.84'	A-13: Corner of Sections 31, T15NR9E & 6, T14NR9E 1" bolt in monument box from which: RP Tag in SW face of PP, N69°E, 82.45' Road Sign Post, S72°E, 58.57' Sign Post (M-25), S25°W, 71.13' RP Tag in SE face of PP, N59°W, 55.23' B-13, T iron w/cap#39089, S89°42'14"E, 800.17'
--	--

Signed by James T. Meek
Surveyor's Michigan License No. 39089

Date 12-12-94

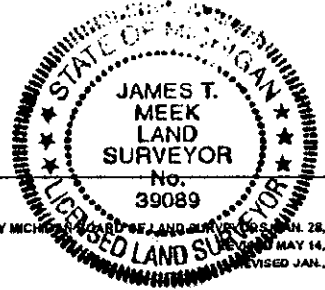

APPROVED AT PEER BOARD MEETING 12-10-94 RLB