

SURVEY & REMONUMENTATION

LAND CORNER RECORDATION CERTIFICATE
Filing Requirement of Act 74, Mich. P.A. 1970

Re-Mon. Liber 1, Page 10

REMONUMENTATION
APR 27 1995

For Corners in

Huron **COMMISSION** Located in:
(County)

Corner Code #

- 1. Public Land survey Sebewaing T 15 N R 9 E
T _____ R _____
T _____ R _____
T _____ R _____
- 2. Property Controlling S _____ T _____ R _____
in Section S _____ T _____ R _____
- 3. Miscellaneous S _____ T _____ R _____

D-13 C-13

STATE OF MICHIGAN
HURON COUNTY
RECORDED

13 DEC 94 4:31 P.M.

FRANCES L. HOLDWICK
REGISTER OF DEEDS

Register of Deeds Stamp & File Number

- 4. Lot No. _____, Recorded Plat _____
- 5. Private Claims _____

I, James T. Meek, in a field survey on October, 1994, do hereby certify that under requirements of P.A. 74, Michigan P.A. of 1970, the corner points mentioned in lines 1 and 2 above were in conformance with regulations and rules thereof as required in the current manual of survey instructions of the United States Department of the Interior, Bureau of Land Management or by a decree of a Court of Law and/or that the corner points mentioned in lines 3, 4 and 5 above were in conformance with the rules of the Michigan Board of Land Surveyors or by a Decree of a Court of Law, established, re-established, monumented, re-monumented, recovered, found as

A	B	C	D	E	F	G	H	I	J	K	L	M
2	6	5	4	3	2	1						
3												
4	7	8	9	10	11	12						
5												
6	18	17	16	15	14	13						
7												
8	19	20	21	22	23	24						
9												
10	30	29	28	27	26	25						
11												
12	31	32	33	34	35	36						
13												

NOTE: Not more than 4 corners, all in the same town and range, may be recorded on this certificate.

A. Description of original monument and accessories and/or subsequent restoration:
Original survey, South Bdy. T15N, R9E, 1835, Harvey Parke, D.S.

D-13: South 1/4 Corner of Section 32,
Post
Beech 12", N43 1/2°E, 43 1/2 links
Lynn 7", N77°W, 24 links

C-13: Corner of Sections 31 & 32
Post
Sugar Maple 14", N68°W, 36 links
Sugar Maple 18", N77°E, 15 links

No County Surveyor's Record
Huron Survey, L1, Page 341,
Pd. Remains of Cedar Post,
Raised with 1/2" steel pin

County Surveyors Record: 3439.92 ft. from M-25 mon

B. Description of corner evidence found and/or method applied in restoring or reestablishing corner:

D-13: South 1/4 Corner of Section 32,

There is no remaining evidence of the original corner position or the remonumentation in 1972.

C-13: Corner of Sections 31 & 32
Found 1/2" iron bar, 3" below ground
3'± South of cl Huron Line Rd. (E-W)
3'± West of extended cl of Miller Rd. (N-S)

Accepted as best available evidence of original corner position.

C. Description of monument for corner and accessories established to perpetuate locating the position of the corner:

D-13: South 1/4 Corner of Section 32,
At proportionate distance;
Set 'T' iron w/cap #39089, 18" long, 6" below grd.
from which:
1/2" iron rod, 24" long, N45°E, 23.68'
PK Nail on NE side 12" Ash, S77°W, 85.85'
PK Nail on SE side 15" Ash, N52°W, 68.45'
1/2" pipe, 21" long, S45°E, 10.32'
6'± South of cl Huron Line Rd.
1/2" iron, N90°W, 117.25'
C-13, 1/2" iron, N89°41'43"W, 2640.03'
E-13, 1/2" iron, S89°41'43"E, 2640.03'


C-13: Corner of Sections 31 & 32
1/2" iron bar, 3" below grd.
from which:
Road Sign Post, N18°W, 52.90'
Sign Post, N10°E, 91.30'
Road Sign Post, S70°W, 111.00'
East leg of direction sign, S20°E, 12.40'
1/2" iron rod, N90°W, 105.25'
D-13, T iron w/cap #39089, S89°41'43"E, 2640.03'
B-13, T iron w/cap #39089, N89°42'14"W, 2640.84'

Signed by James T. Meek

Date 12-12-94

Surveyor's Michigan License No. 39089

APPROVED AT PEER BOARD MEETING 12-10-94 RLB

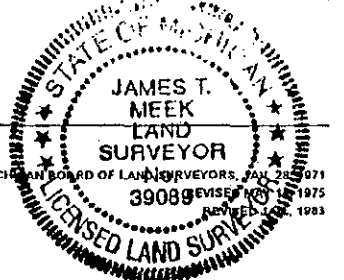

FORM APPROVED BY MICHIGAN BOARD OF LAND SURVEYORS, JUL 25, 1971
REVISED 1975
1983