

SURVEY & REMONUMENTATION

APR 27 1995

Re-Mon. Liber 1, Page 11

REMONUMENTATION COMMISSION

LAND CORNER RECORDATION CERTIFICATE
Filing Requirement of Act 74, Mich. P.A. 1970

For Corners in Located in: Corner Code #

<u>Huron</u> (County)					
1. Public Land survey	Sebewaing	T 15 N R 9 E	F-13	E-13	
		T _____ R _____			
		T _____ R _____			
		T _____ R _____			
2. Property Controlling in Section	S _____	T _____ R _____			
	S _____	T _____ R _____			
3. Miscellaneous	S _____	T _____ R _____			

STATE OF MICHIGAN
HURON COUNTY
RECORDED

13 DEC 94 4:31 P.M.

FRANCES L. HOLMICK
REGISTER OF DEEDS

Register of Deeds Stamp & File Number

4. Lot No. _____, Recorded Plat _____
5. Private Claims _____

	A	B	C	D	E	F	G	H	I	J	K	L	M
2	6		5		4		3		2		1		
3													
4	7		8		9		10		11		12		
6													
6	18		17		16		15		14		13		
7													
8	19		20		21		22		23		24		
9													
10	30		29		28		27		26		25		
11													
12	31		32		33		34		35		36		
13													

I, James T. Meek, in a field survey on October, 1994

do hereby certify that under requirements of P.A. 74, Michigan P.A. of 1970, the corner points mentioned in lines 1 and 2 above were in conformance with regulations and rules thereof as required in the current manual of survey instructions of the United States Department of the Interior, Bureau of Land Management or by a decree of a Court of Law and/or that the corner points mentioned in lines 3, 4 and 5 above were in conformance with the rules of the Michigan Board of Land Surveyors or by a Decree of a Court of Law; established, re-established, monumented, re-monumented, recovered, found as

NOTE: Not more than 4 corners, all in the same town and range, may be recorded on this certificate.

A. Description of original monument and accessories and/or subsequent restoration:

Original survey, 1835, Harvey Parke, D.S.

F-13: South ¼ Corner of Section 33,
Post
B. Ash 17", N43°E, 62¼ links
Birch 10", N68°W, 15¼ links

E-13: Corner of Sections 32 & 33
Post
Elm 15", N70°W, 50 links
Lynn 7", N45°E, 14 links

No County Surveyor's Record

County Surveyors Record: Cedar Post
Huron Survey L 1, Pg 341: Fd 1¼" pipe, raised ½" pin
Tuscola Survey L 509, Pg 570: 1¼" pipe

B. Description of corner evidence found and/or method applied in restoring or reestablishing corner:

F-13: South ¼ Corner of Section 33,
Found ¾" iron w/cap no top, 1" below grd.
2'± South of cl Huron Line Rd. (E-W)

E-13: Corner of Sections 32 & 33
Found ½" iron pin, 3" below grd.
At intersection of Huron Line Rd. (E-W) and Caro Rd. (N-S) from North

Accepted as best available evidence of original corner position

Accepted as best available evidence of original corner position

C. Description of monument for corner and accessories established to perpetuate locating the position of the corner:


F-13: South ¼ Corner of Section 33,
¾" iron w/cap no top, 1" below grd.
from which:
2" pipe next to Fence post, N6°E, 18.90'
T iron w/cap #39089, S37°E, 22.75'
T iron w/cap #39089, S50°W, 23.60'
¾" iron (bent), N90°W, 117.25'
E-13, ½" iron, N89°44'30"W, 2638.36'
G-13, ¾" iron in mon box, S89°26'26"E, 2638.59'

E-13: Corner of Sections 32 & 33
¾" iron pin, 3" below grd.
from which:
East leg of dir. sign, S13°W, 20.05'
NE cor of NE wingwall, S68°W, 53.40'
Road Sign post, N65°W, 70.15'
Spike on NW side of TP, N50°E, 79.50'
F-13, ¾" iron, S89°44'30"E, 2638.36'
D-13, T iron, N89°41'43"W, 2640.03'

Signed by James T. Meek
Surveyor's Michigan License No. 39089

Date 12-12-94

APPROVED AT PEER BOARD MEETING 12-10-94 RLB

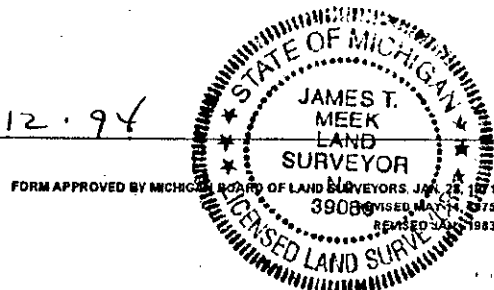

FORM APPROVED BY MICHIGAN BOARD OF LAND SURVEYORS, JAN. 28, 1975