

**SURVEY & REMONUMENTATION**

*Re-Mon. Liber 1, Page 11*

REMONUMENTATION 1995

**LAND CORNER RECORDATION CERTIFICATE**  
Filing Requirement of Act 74, Mich. P.A. 1970

**COMMISSION**

For Corners in  
Located in:

Corner Code #

Huron  
(County)

- 1. Public Land survey Sebewaing T 15 N R 9 E  
T \_\_\_\_\_ R \_\_\_\_\_  
T \_\_\_\_\_ R \_\_\_\_\_  
T \_\_\_\_\_ R \_\_\_\_\_
- 2. Property Controlling in Section S \_\_\_\_\_ T \_\_\_\_\_ R \_\_\_\_\_  
S \_\_\_\_\_ T \_\_\_\_\_ R \_\_\_\_\_
- 3. Miscellaneous S \_\_\_\_\_ T \_\_\_\_\_ R \_\_\_\_\_

F-13 E-13  
\_\_\_\_\_  
\_\_\_\_\_  
\_\_\_\_\_

STATE OF MICHIGAN  
HURON COUNTY  
RECORDED

13 DEC 94 4:31 P.M.

FRANCES L. HOLDNICK  
REGISTER OF DEEDS

Register of Deeds Stamp & File Number

- 4. Lot No. \_\_\_\_\_, Recorded Plat \_\_\_\_\_
- 5. Private Claims \_\_\_\_\_

I, James T. Meek, in a field survey on October, 1994

do hereby certify that under requirements of P.A. 74, Michigan P.A. of 1970, the corner points mentioned in lines 1 and 2 above were in conformance with regulations and rules thereof as required in the current manual of survey instructions of the United States Department of the Interior, Bureau of Land Management or by a decree of a Court of Law and/or that the corner points mentioned in lines 3, 4 and 5 above were in conformance with the rules of the Michigan Board of Land Surveyors or by a Decree of a Court of Law, established, re-established, monumented, re-monumented, recovered, found as

	A	B	C	D	E	F	G	H	I	J	K	L	M
2	6	5				4		3			2		1
3													
4	7	8				9		10		11			12
5													
6	18	17				16		15		14			13
7													
8	19	20				21		22		23			24
9													
10	30	29				28		27		26			25
11													
12	31	32				33		34		35			36
13													

**NOTE: Not more than 4 corners, all in the same town and range, may be recorded on this certificate.**

**A. Description of original monument and accessories and/or subsequent restoration:**

Original survey, 1835, Harvey Parke, D.S.

F-13: South 1/4 Corner of Section 33,  
Post

B. Ash 17", N43°E, 62 1/4 links  
Birch 10", N68°W, 15 1/4 links

No County Surveyor's Record

E-13: Corner of Sections 32 & 33  
Post

Elm 15", N70°W, 50 links  
Lynn 7", N45°E, 14 links

County Surveyors Record: Cedar Post  
Huron Survey L 1, Pg 341: Pd 1 1/2" pipe, raised 1/2" pin  
Tuscola Survey L 509, Pg 570: 1 1/2" pipe

**B. Description of corner evidence found and/or method applied in restoring or reestablishing corner:**

F-13: South 1/4 Corner of Section 33,  
Found 1/2" iron w/cap no top, 1" below grd.  
2'± South of cl Huron Line Rd. (E-W)

Accepted as best available evidence  
of original corner position

E-13: Corner of Sections 32 & 33  
Found 1/2" iron pin, 3" below grd.  
At intersection of Huron Line Rd. (E-W) and  
Caro Rd. (N-S) from North

Accepted as best available evidence  
of original corner position

**C. Description of monument for corner and accessories established to perpetuate locating the position of the corner:**


F-13: South 1/4 Corner of Section 33,  
1/2" iron w/cap no top, 1" below grd.  
from which:  
2" pipe next to Fence post, N6°E, 19.90'  
T iron w/cap #39089, S37°E, 22.75'  
T iron w/cap #39089, S50°W, 23.60'  
1/2" iron (bent), N90°W, 117.25'  
E-13, 1/2" iron, N89°44'30"W, 2638.36'

E-13: Corner of Sections 32 & 33  
1/2" iron pin, 3" below grd.  
from which:  
East leg of dir. sign, S13°W, 20.05'  
NE cor of NE wingwall, S68°W, 53.40'  
Road Sign post, N65°W, 70.15'  
Spike on NW side of TP, N50°E, 79.50'  
F-13, 1/2" iron, S89°44'30"E, 2638.36'  
D-13, T iron, N89°41'43"W, 2640.03'

Signed by *James T. Meek*  
Surveyor's Michigan License No. 39089

Date 12-12-94

APPROVED AT PEER BOARD MEETING 12-10-94 RLB

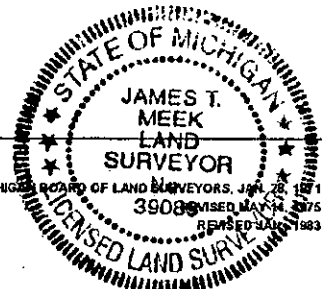

FORM APPROVED BY MICHIGAN BOARD OF LAND SURVEYORS, JAN. 28, 1975  
39089 ISSUED MARCH 12, 1975  
REPEALED MARCH 12, 1983