

SURVEY & REMONUMENTATION

Re-Mon. Liber 1, Page 12

LAND CORNER RECORDATION CERTIFICATE
Filing Requirement of Act 74, Mich. P.A. 1970

REMONUMENTATION APR 27 1995

For Corners in **COMMISSION**
Huron
(County)

Located in:

Corner Code #

- 1. Public Land survey Sebawaing T 15 N R 9 E
- 2. Property Controlling in Section S _____ T _____ R _____
- 3. Miscellaneous S _____ T _____ R _____

H-13 G-13

STATE OF MICHIGAN
HURON COUNTY
RECORDED

13 DEC 94 4:31 P.M.

FRANCES L. HOLDWICK
REGISTER OF DEEDS

Register of Deeds Stamp & File Number

- 4. Lot No. _____, Recorded Plat _____
- 5. Private Claims _____

A	B	C	D	E	F	G	H	I	J	K	L	M
2	6	5	4	3	2	1						
3												
4	7	8	9	10	11	12						
5												
6	18	17	16	15	14	13						
7												
8	19	20	21	22	23	24						
9												
10	30	29	28	27	26	25						
11												
12	31	32	33	34	35	36						
13												

I, James T. Meek, in a field survey on October, 1994

do hereby certify that under requirements of P.A. 74, Michigan P.A. of 1970, the corner points mentioned in lines 1 and 2 above were in conformance with regulations and rules thereof as required in the current manual of survey instructions of the United States Department of the Interior, Bureau of Land Management or by a decree of a Court of Law and/or that the corner points mentioned in lines 3, 4 and 5 above were in conformance with the rules of the Michigan Board of Land Surveyors or by a Decree of a Court of Law, established, re-established, monumented, re-monumented, recovered, found as

NOTE: Not more than 4 corners, all in the same town and range, may be recorded on this certificate.

A. Description of original monument and accessories and/or subsequent restoration:

Original survey, 1835, Harvey Parke, D.S.

H-13: South 1/4 Corner of Section 34
Post
Ironwood 6", N63°E, 7 links
Sugar Maple 8", N60°W, 47 links

G-13: Corner of Sections 33 & 34
Post
Lynn 30", N73°E, 28 links
Lynn 7", N73°W, 30 links

County Surveyor's Record: Axle
Tuscola Survey L 486, Page 427: 1" axle shaft

County Surveyors Record: Axle
Tuscola Survey L 486, Pg 427: 1" axle shaft
Huron Survey L 4, Pg 284: 1" axle shaft

B. Description of corner evidence found and/or method applied in restoring or reestablishing corner:

H-13: South 1/4 Corner of Section 34,
Found 1 1/4" iron bar, 2" below grd.
1' ± South of cl Huron Line Rd.
Centerline of ditch (E-W), South, 25' ±

G-13: Corner of Sections 33 & 34
Found 3/4" iron bar in monument box
At intersection of Huron Line Rd. (E-W) and
Lange Rd. (N-S) from North

Accepted as best available evidence
of original corner position

Accepted as best available evidence
of original corner position

C. Description of monument for corner and accessories established to perpetuate locating the position of the corner:

H-13: South 1/4 Corner of Section 34,
1 1/4" iron bar, 3" below grd.
from which:
Fence Post, N81°E, 144.50'
'Yield' Sign Post, S68°W, 110.65'
Nail on NE side of PP, N84°W, 154.40'
1/2" iron (bent), N90°W, 119.62'
G-13, 3/4" iron, N89°57'18"W, 2633.77'
I-13, 1 1/4" iron, S89°50'26"E, 2635.91'


G-13: Corner of Sections 33 & 34
3/4" iron bar in monument box
from which:
Sign Post (Huron County), N13°E, 68.40'
East leg of direction sign, S12°E, 17.85'
'Stop' Sign post, N15°W, 68.85'
Nail on SE side of PP, N48°E, 46.17'
3/4" iron in monument box, N90°W, 123.38'
H-13, 1 1/4" iron, S89°57'18"E, 2633.77'
F-13, 3/4" iron, N89°26'26"W, 2638.59'

Signed by [Signature]

Date 12-12-94

Surveyor's Michigan License No. 39089

APPROVED AT PEER BOARD MEETING 12-10-94 RLB

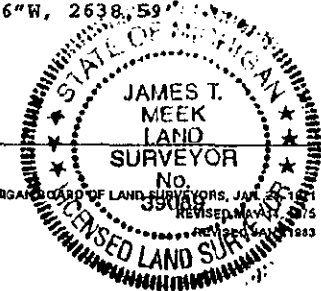

FORM APPROVED BY MICHIGAN BOARD OF LAND SURVEYORS, JAN 1985, REVISED MAY 1985