

**SURVEY & REMONUMENTATION LAND CORNER RECORDATION CERTIFICATE**  
**Filing Requirement of Act 74, Mich. P.A. 1970**

*Re-Mon. Liller, Page 14*

APR 27 1995

For Corners in

Located in: Huron (County) **COMMISSION**

Corner Code # L-13 K-13

1. Public Land survey	Sebevaing	T 15 N R 9 E	<u>L-13</u> <u>K-13</u>
		T _____ R _____	_____
		T _____ R _____	_____
		T _____ R _____	_____
2. Property Controlling in Section	S _____	T _____ R _____	_____
	S _____	T _____ R _____	_____
3. Miscellaneous	S _____	T _____ R _____	_____

STATE OF MICHIGAN  
HURON COUNTY  
RECORDED

13 DEC 94 4:32 P.M.

FRANCES L. HOLDWICK  
REGISTER OF DEEDS

Register of Deeds Stamp & File Number

4. Lot No. \_\_\_\_\_, Recorded Plat \_\_\_\_\_
5. Private Claims \_\_\_\_\_

	A	B	C	D	E	F	G	H	I	J	K	L	M
2	6		6		4		3		2		1		
3													
4	7		8		9		10		11		12		
5													
6	18		17		16		15		14		13		
7													
8	19		20		21		22		23		24		
9													
10	30		29		28		27		26		25		
11													
12	31		32		33		34		35		36		
13													

I, James T. Meek, in a field survey on October, 1994, do hereby certify that under requirements of P.A. 74, Michigan P.A. of 1970, the corner points mentioned in lines 1 and 2 above were in conformance with regulations and rules thereof as required in the current manual of survey instructions of the United States Department of the Interior, Bureau of Land Management or by a decree of a Court of Law and/or that the corner points mentioned in lines 3, 4 and 5 above were in conformance with the rules of the Michigan Board of Land Surveyors or by a Decree of a Court of Law; established, re-established, monumented, re-monumented, recovered, found as

**NOTE: Not more than 4 corners, all in the same town and range, may be recorded on this certificate.**

**A. Description of original monument and accessories and/or subsequent restoration:**

Original Survey South Bdy. T15NR9E, 1835, Harvey Parke, D.S.

L-13: South ¼ Corner of Section 36, Post Cedar 11", N37°W, 27 links Birch 7", N83°E, 29 links  No County Surveyor's Record Huron Survey L 4, Page 650: ¼" pipe	K-13: Corner of Sections 35 & 36 Post Tamarac 9", N45°W, 15½ links Cedar 7", N68°E, 14½ links  County Surveyors Record: Iron Pin Huron Survey L 2, Pg 476: Rerod w/cap #11192 Huron Survey L 4, Pg 650: ¼" iron
--	--

**B. Description of corner evidence found and/or method applied in restoring or reestablishing corner:**


L-13: South ¼ Corner of Section 36, Found ¼" pipe, 3" below ground 5'± South of cl Huron Line Rd. 18'± East of extended cl of ditch(N-S) from South.  Accepted as the best available evidence of original corner position	K-13: Corner of Sections 35 & 36 Found ½" iron w/cap #11192, 3" below grd. 7'± South of cl Huron Line Rd. (E-W) 8'± West of extended cl of Volz Road(N-S)  Accepted as the best available evidence of original corner position
--	---

**C. Description of monument for corner and accessories established to perpetuate locating the position of the corner:**

L-13: South ¼ Corner of Section 36, ¼" pipe, 3" below grd. from which: PK nail on SE side of PP, N °E, T iron w/cap #39089, S61°E, 19.15' T iron w/cap #39089, S66°W, 20.70' ¼" iron, S90°W, 36.31' M-13, 1" pipe in mon box, N90°E, 2633.45' K-13, ¼" iron w/cap #11192, N89°59'44"W, 2638.93'	K-13: Corner of Sections 35 & 36 ½" iron w/cap #11192, 3" below grd. from which: Sign Post (Huron County), N20°E, 61.48' ¼" iron (bent), S64°E, 131.92' Road Sign post, S63°W, 52.70' Tag on PP, N34°W, 70.54' L-13, ¼" pipe, S89°59'44"E, 2638.93' J-13, T iron, w/cap #39089, N89°49'30"W, 2633.80'
---	---

Signed by James T. Meek Date 12-12-94

Surveyor's Michigan License No. 39089

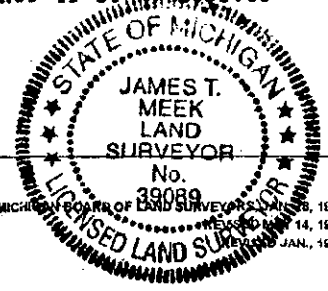

APPROVED AT PEER BOARD MEETING, 12-10-94 RLB