

REMONUMENTATION SURVEY & LAND CORNER RECORDATION CERTIFICATE
 Filing Requirement of Act 74, Mich. P.A. 1970

For Corners in

Huron APR 27 1995 located in:

Corner Code #

COMMISSION

1. Public Land survey: Sebawaing T 15 N R 9 E M-13 ✓
 Columbia T 14 N R 9 E M-1
 Brookfield T 15 N R 10 E A-13
 Elmwood T 14 N R 10 E A-1
2. Property Controlling S T R
 in Section S T R
3. Miscellaneous S T R
4. Lot No. , Recorded Plat
5. Private Claims

STATE OF MICHIGAN
 HURON COUNTY
 RECORDED

13 DEC 94 4:31 P.M.

FRANCES L. HOLDWICK
 REGISTER OF DEEDS

Register of Deeds Stamp & File Number

I, James T. Meek, in a field survey on October, 1994, do hereby certify that under requirements of P.A. 74, Michigan P.A. of 1970, the corner points mentioned in lines 1 and 2 above were in conformance with regulations and rules thereof as required in the current manual of survey instructions of the United States Department of the Interior, Bureau of Land Management or by a decree of a Court of Law and/or that the corner points mentioned in lines 3, 4 and 5 above were in conformance with the rules of the Michigan Board of Land Surveyors or by a Decree of a Court of Law; established, re-established, monumented, re-monumented, recovered, found as

NOTE: Not more than 4 corners, all in the same town and range, may be recorded on this certificate.

A. Description of original monument and accessories and/or subsequent restoration:

Original survey, East Bdy. T14NR9E and South Bdy. T15NR9E, 1835, Harvey Parke D.S.

M-13 Corner of Ts 14 & 15 N, Rs 9 & 10 E;

Post

Birch 12", N57°E, 27 links

Elm 12", S43°W, 28 links

No County Surveyor's Record.

No Recorded Surveys.

B. Description of corner evidence found and/or method applied in restoring or reestablishing corner:

M-13 Corner of Ts 14 & 15 N, Rs 9 & 10 E;

Found 1" pipe in monument box

1 1/2' East of the centerline of BayPort Rd. (N-S)

At the intersection with Huron Line Rd. (E-W), from East

Accepted as the best available evidence of the original corner position.

C. Description of monument for corner and accessories established to perpetuate locating the position of the corner:

M-13 Corner of Ts 14 & 15 N, Rs 9 & 10 E;

1" pipe in monument box

from which:

Tag in Power Pole, bears N48°W, 49.75 feet


Road Sign Post (Huron Line Rd. & BayPort Rd.), bears N64°E, 34.77 feet

PK nail in top of West concrete bridge abutment, bears S26°W, 34.74 feet

PK nail in top of East concrete bridge abutment, bears S18°E, 33.69 feet

L-13, 3/4" pipe, N90°W, 2633.45'

	T14N R10E											T14N R9E															
	A	B	C	D	E	F	G	H	I	J	K	L	M														
2	6			5			4			3			2			1											
3																											
4	7			8			9			10			11			12											
5																											
6	18			17			16			15			14			13											
7																											
8	19			20			21			22			23			24											
9																											
10	30			29			28			27			26			25											
11																											
12	31			32			33			34			35			36											
13																											
	T15N R10E											T15N R9E															

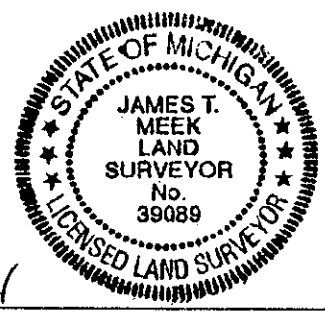

Signed by [Signature] Date 12-12-94
 Surveyor's Michigan License No. 39089

APPROVED AT PEER BOARD MEETING 12-10-94 RLB