Re-Mon Liber 2, Page 91

2000 REMONUMENTATION

LAND CORNER RECORDATION CERTIFICATE

Filing Requirement of Act 74, Mich. P.A. 1970

STATE OF MICHIGAN
HURON COUNTY
RECORDED

29 NOV 2000 11:21 AM

FRANCES L. HOLBWICK
REGISTER OF DEEDS

Register of Deeds Stamp & File Number

SURVEY & MONUMENTATION
JAN 19 2001
SECTION

For Corners in Huron (County)

	Located in:	Corner Code #
1. Public Land survey: Sebewaing	T 15_N_ R 9_E	A-9 ✓
	T____ R____	A-10
	T____ R____	
	T____ R____	
2. Property Controlling	S ____ T____ R____	
in Section	S ____ T____ R____	
3. Miscellaneous	S ____ T____ R____	
Property in Sec.	S ____ T____ R____	

4. Lot No. _____, Recorded Plat _____
5. Private Claims _____

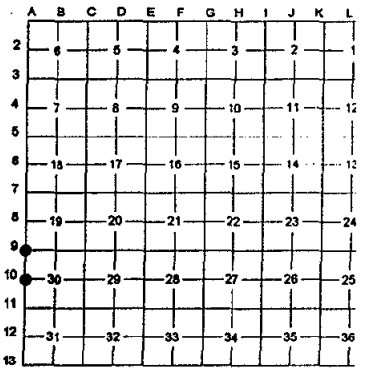

I, James T. Meek, in a field survey on October 1, 2000, do hereby certify that under requirements of P.A. 74, Michigan P.A. of 1970, the corner points mentioned in lines 1 and 2 above were in conformance with regulations and rules thereof as required in the current manual of survey instructions of the United States Department of the Interior, Bureau of Land Management or by a decree of a Court of Law and/or that the corner points mentioned in lines 3, 4 and 5 above were in conformance with the rules of the Michigan Board of Land Surveyors or by a Decree of a Court of Law; established, re-established, monumented, re-monumented, recovered, found as expessed below:

NOTE: **Not more than 2 corners, all in the same town and range, may be recorded on this certificate.**

A. Description of original monument and accessories and/or subsequent restoration:

Original survey, West Bdy. T15NR9E, 1835, Harvey Parke D.S.

A-9 Corner of Sections 19, 30
Post
Lynn 14", N25°W, 11 links
Beech 10", S6°E, 23 links

County Surveyor's Record: none
Recorded Surveys: none
LCRC: none

A-10 West ¼ Corner of Section 30
Not monumented

County Surveyor's Record: none
Recorded Surveys: none
LCRC: none

B. Description of corner evidence found and/or method applied in restoring or reestablishing corner:

A-9 Corner of Sections 19, 30

Found no evidence of the original corner position
Set ½" iron w/cap #39089 at proportionate distance between M-7 & M8, T15NR8E Centerline of Wildner Road bears East

A-10 West ¼ Corner of Section 30

Found no evidence of the original corner position
Set ½" iron w/cap #39089 at proportionate distance between M-8 & M-9, T15NR8E

C. Description of monument for corner and accessories established to perpetuate locating the position of the corner:

A-9 Corner of Sections 19, 30
½" iron w/cap #39089
From which:
½" iron bears N1°E, 96.9'
Tag in 6" wood post bears N1°E, 92.0'
Tag in 4" Ash bears N25°W, 93.9'
½" iron bears N20°W, 81.8'
M-7, Corner of Sections 13 & 24, T15NR8E bears N0°04'30"E, 63.94'
M-8, East ¼ corner of Section 24, T15NR8E bears S0°04'30"W, 2572.98'

A-10 West ¼ Corner of Section 30
½" iron w/cap #39089
From which:
Tag in 9" Ash bears N2°E, 115.3'
Tag in wood post bears S70°E, 64.4'
Tag in 6" Elm bears N51°W, 75.2'
Top of pointed rock bears N25°W, 29.3'
M-8, East ¼ corner of Section 24, T15NR8E bears N0°04'30"E, 71.35'
M-9, Corner of Sections 24 & 25, T15NR8E bears S0°04'30"W, 2565.57'

Signed by _____ Date 10-2-2000

Surveyor's Michigan License No. 39089

APPROVED AT PEER BOARD MEETING 11-02-00 RLB

STATE OF MICHIGAN
JAMES T. MEEK
LAND SURVEYOR
No. 39089
LICENSED LAND SURVEYOR

FORM APPROVED BY MICHIGAN BOARD OF LAND SURVEYORS, JAN. 28, 1
REVISED MAY 14, 1
REVISED JAN., 1
REVISED OCT., 1