

*Common to A13 - Winsor Twp. - T16N-R10E
 *Common to M13 - Fair Haven Twp. - T16N-R9E
 *Common to M01 - Sebewaing Twp. - T15N-R9E

Re-Mon Liber 1 Page 131

REMONUMENTATION

LAND CORNER RECORDATION CERTIFICATE
 Filing Requirement of Act 74, Mich. P.A. 1970

For Corners in

<u>Huron</u> (County)	Located in:	Corner Code #
1. Public Land survey: Brookfield	T 15 N R 10 E	A-1 ✓
	T 16 N R 9 E	M-13
	T 16 N R 10 E	A-13
	T 15 N R 9 E	M-1
2. Property Controlling in Section	S ___ T ___ R ___	___
	S ___ T ___ R ___	___
3. Miscellaneous	S ___ T ___ R ___	___

STATE OF MICHIGAN
 HURON COUNTY
 RECORDED

9 DEC 97 11:14 A.M.

FRANCES L. HOLDWICK
 REGISTER OF DEEDS

Register of Deeds Stamp & File Number

4. Lot No. _____, Recorded Plat _____
 5. Private Claims _____

I, James T. Meek, in a field survey on October 30, 1997, do hereby certify that under requirements of P.A. 74, Michigan P.A. of 1970, the corner points mentioned in lines 1 and 2 above were in conformance with regulations and rules thereof as required in the current manual of survey instructions of the United States Department of the Interior, Bureau of Land Management or by a decree of a Court of Law and/or that the corner points mentioned in lines 3, 4 and 5 above were in conformance with the rules of the Michigan Board of Land Surveyors or by a Decree of a Court of Law; established, re-established, monumented, re-monumented, recovered, found as expressed below:

	A	B	C	D	E	F	G	H	I	J	K	L	M
2	6		5		4		3		2		1		
3													
4	7		8		9		10		11		12		
5													
6	18		17		16		15		14		13		
7													
8	19		20		21		22		23		24		
9													
10	30		29		28		27		26		25		
11													
12	31		32		33		34		35		36		
13													

NOTE: Not more than 4 corners, all in the same town and range, may be recorded on this certificate.

A. Description of original monument and accessories and/or subsequent restoration:
 Original survey, West Bdy. T15NR10E, 1835, Harvey Parke D.S.

A-1 Corner of Townships 15 and 16 North, Ranges 9 and 10 East
 Post
 Lynn 20", N82°E, 29 links
 B. Oak 20", S81°W, 41 links

County Surveyor's Record: 3/4" iron
 Recorded Surveys: L4, P552; L1, P477
 LCRC: none

SURVEY &
 REMONUMENTATION

JAN 22 1998

SECTION

B. Description of corner evidence found and/or method applied in restoring or reestablishing corner:

A-1 Corner of Townships 15 and 16 North, Ranges 9 and 10 East

Found 1" iron in mon box
 At the intersection of Kilmanagh Rd. and Bay Port Rd.

Accepted as the best available evidence of the original corner position.

C. Description of monument for corner and accessories established to perpetuate the position of the corner:

A-1 Corner of Townships 15 and 16 North, Ranges 9 and 10 East


1" iron in mon box

From which:

Tag in PP bears N48°E, 40.9'
 Road sign post bears S22°E, 40.0'
 Tag in PP bears S50°W, 41.7'
 Road sign post bears N35°W, 35.4'

Signed by [Signature]
 Surveyor's Michigan License No. 39089

Date _____

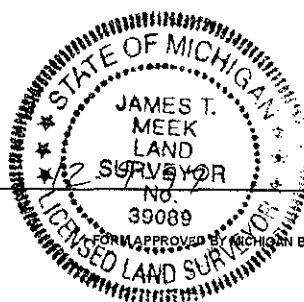

APPROVED AT PEER BOARD MEETING Nov. 25, 1997 RL13