

**SURVEY &  
REMONUMENTATION**

OCT 29 1996

*Re - Mon Liber 1, Page 21*

**COMMISSION LAND CORNER RECORDATION CERTIFICATE**  
REMONUMENTATION Filing Requirement of Act 74, Mich. P.A. 1970

For Corners in  
Huron  
(County)

Located in: Brookfield T 15 N R 10 E

Corner Code # B-13

1. Public Land survey T 15 N R 10 E  
T      R      C-13  
T      R       
T      R     


2. Property Controlling S      T      R       
in Section S      T      R     

3. Miscellaneous S      T      R     

4. Lot No.           , Recorded Plat           

5. Private Claims           

STATE OF MICHIGAN  
HURON COUNTY  
RECORDED  
12 SEP 96 11:22 A.M.  
FRANCES L. HOLDWICK  
Register of Deeds

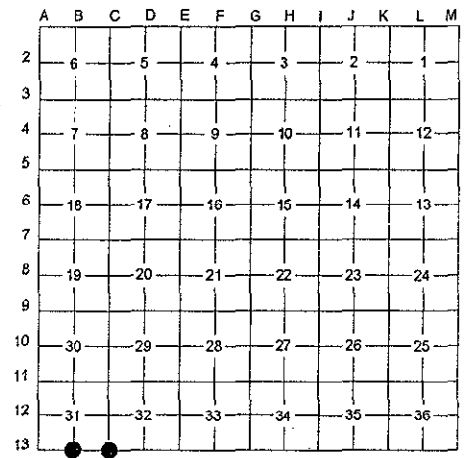

I, James T. Meek, in a field survey on August 30, 1996  
do hereby certify that under requirements of P.A. 74, Michigan P.A. of 1970, the corner points mentioned in lines 1 and 2 above were in conformance with regulations and rules thereof as required in the current manual of survey instructions of the United States Department of the Interior, Bureau of Land Management or by a decree of a Court of Law and/or that the corner points mentioned in lines 3, 4 and 5 above were in conformance with the rules of the Michigan Board of Land Surveyors or by a Decree of a Court of Law; established, re-established, monumented, re-monumented, recovered, found as expressed below:

NOTE: Not more than 4 corners, all in the same town and range, may be recorded on this certificate.

A. Description of original monument and accessories and/or subsequent restoration:

Original Survey South Bdy. T15NR10E, 1835, Harvey Parke, D.S.

B-13: South 1/4 Corner of Section 31  
Post  
Lynn 17", N67°E, 4 links  
Cedar 15", N29 1/2°W, 23 links

C-13: Corner of Sections 31 & 32  
Post  
W. Ash 12", N63°W, 13 links  
B. Ash 10", N67 1/2°E, 22 links

No County Surveyor's Record, recorded surveys or LCRC

County Surveyors Record: T iron  
Huron Survey L 1, Pg 72: T iron  
LCRC, Liber 1, Page 8: T iron

B. Description of corner evidence found and/or method applied in restoring or reestablishing corner:

B-13: South 1/4 Corner of Section 31

There is no remaining evidence of the original corner position

C-13: Corner of Sections 31 & 32

Found T iron, 6" below grd.  
6' ± South of centerline Huron Line Rd.

Accepted as the best available evidence of original corner position

C. Description of monument for corner and accessories established to perpetuate locating the position of the corner:

B-13: South 1/4 Corner of Section 31

At proportionate distance,  
Set PK nail in concrete bridge deck

From which:  
Intersection of SW wing wall and bridge deck bears North, 1.25' and East, 3.9'  
Centerline Huron Line Rd. bears South, 9.0'  
Centerline drain bears North  
Nail in power pole bears N26°W, 41.7'  
1/2" iron bears S44°W, 16.0'  
1/2" iron bears S14°E, 35.0'  
1/2" iron, N35°E, 38.0'

C-13: Corner of Sections 31 & 32

Set T iron w/cap #39089,  
3" below grd. over T iron

From which:  
Stop sign post bears S45°E, 37.4'  
Nail in power pole bears N42°W, 49.6'  
West direction sign post bears N27°E, 33.2'  
East direction sign post bears S33°W, 9.6'  
1/2" iron, 3" below grd. bears East, 12.85'

Signed by James T. Meek Date Sept 11 1996  
Surveyor's Michigan License No. 39089  
APPROVED AT PEER BOARD MEETING, 9-9-96 R.L.B.

