

OCT 29 1996

COMMISSION
REMONUMENTATION

LAND CORNER RECORDATION CERTIFICATE
Filing Requirement of Act 74, Mich. P.A. 1970

Re-Mon Leher 1, Page 25

For Corners in

	<u>Huron</u> (County)	Located in:	Corner Code #
1. Public Land survey	Brookfield	T <u>15</u> N R <u>10</u> E	J-13
		T _____ R _____	<u>K-13</u>
		T _____ R _____	_____
		T _____ R _____	_____
2. Property Controlling in Section	S _____	T _____ R _____	_____
	S _____	T _____ R _____	_____
3. Miscellaneous	S _____	T _____ R _____	_____

STATE OF MICHIGAN
HURON COUNTY
RECORDED

12 SEP 96 11:22 A.M.

FRANCES L. HOLDWICK
REGISTER OF DEEDS
Register of Deeds Stamp & File Number

- 4. Lot No. _____, Recorded Plat _____
- 5. Private Claims _____

I, James T. Meek, in a field survey on August 30, 1996,
do hereby certify that under requirements of P.A. 74, Michigan P.A. of 1970, the corner points mentioned
in lines 1 and 2 above were in conformance with regulations and rules thereof as required in the
current manual of survey instructions of the United States Department of the Interior, Bureau of Land
Management or by a decree of a Court of Law and/or that the corner points mentioned in lines 3, 4 and 5
above were in conformance with the rules of the Michigan Board of Land Surveyors or by a Decree of a
Court of Law; established, re-established, monumented, re-monumented, recovered, found as
expressed below:

	A	B	C	D	E	F	G	H	I	J	K	L	M
2	6	5	4	3	2	1							
3													
4	7	8	9	10	11	12							
5													
6	18	17	16	15	14	13							
7													
8	19	20	21	22	23	24							
9													
10	30	29	28	27	26	25							
11													
12	31	32	33	34	35	36							
13													

NOTE: Not more than 4 corners, all in the same town and range, may be recorded on this certificate.

A. Description of original monument and accessories and/or subsequent restoration:
Original Survey South Bdy. T15NR10E, 1835, Harvey Parke, D.S.

J-13	South ¼ Corner of Section 35 Post Hemlock 7", N36½°E, 13 links Beech 6", N34½°W, 27 links	K-13	Corner of Sections 35 and 36 Post Hemlock 13", N80°W, 1½ links Hemlock 18", N68°E, 23 links
	No county surveyors record, recorded surveys or LCRC		County surveyors record: 1" gas pipe No recorded surveys or LCRC


B. Description of corner evidence found and/or method applied in restoring or reestablishing corner:

J-13	South ¼ Corner of Section 35 Found 3" pipe in mon box Centerline of Huron Line Rd. bears North, 1.0' Accepted as the best available evidence of original corner position	K-13	Corner of Sections 35 and 36 Found 1" pipe, 6" below grd. Intersection of Huron Line Rd. and Notter Rd. bears North, 5.0' Accepted as the best available evidence of original corner position
------	---	------	--

C. Description of monument for corner and accessories established to perpetuate locating the position of the corner:

J-13	South ¼ Corner of Section 35 Set T iron with cap #39089, in 3" pipe From which: Nail in power pole bears S25°W, 53.2' Nail in power pole bears N26°W, 68.2' Huron County sign post bears N14°E, 95.3' Concrete ROW marker bears S52°E, 52.6'	K-13	Corner of Sections 35 and 36 Set ½" iron with cap #39089, 3" below ground over 1" pipe From which: Nail in wood post bears S56°W, 35.9' Road sign post bears N22°W, 42.0' Huron County sign post bears N16°E, 57.9' Road sign post bears S62°E, 42.5'
------	--	------	---

Signed by James T. Meek Date September 9, 1996
Surveyor's Michigan License No. 39089

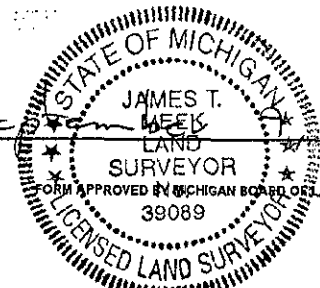

APPROVED AT PEER BOARD MEETING, 9-9-96 RLB