

*Common to A01 - Grant Twp. - T15N-R11E
 *Common to A13 - Oliver Twp. - T16N-R11E
 *Common to M13 - Winsor Twp. - T16N-R10E

Re-Mon Liber 1 Page 123

REMONUMENTATION

LAND CORNER RECORDATION CERTIFICATE
 Filing Requirement of Act 74, Mich. P.A. 1970

STATE OF MICHIGAN
 HURON COUNTY
 RECORDED

For Corners in

Huron
 (County)

Located in:

Corner Code #

9 DEC 97 11:12 A.M.

FRANCES L. HOLDWICK
 REGISTER OF DEEDS

- | | | | |
|---|-----------------------------|--|--------------|
| 1. Public Land survey: Brookfield T <u>15</u> N R <u>10</u> E | | | <u>M-1</u> ✓ |
| | T <u>16</u> N R <u>10</u> E | | <u>M-13</u> |
| | T <u>15</u> N R <u>11</u> E | | <u>A-1</u> |
| | T <u>16</u> N R <u>11</u> E | | <u>A-13</u> |
| 2. Property Controlling | S _____ T _____ R _____ | | |
| in Section | S _____ T _____ R _____ | | |
| 3. Miscellaneous | S _____ T _____ R _____ | | |

Register of Deeds Stamp & File Number

4. Lot No. _____, Recorded Plat _____
 5. Private Claims _____

	A	B	C	D	E	F	G	H	I	J	K	L	M
2	6		5		4		3		2		1		
3													
4	7		8		9		10		11		12		
5													
6	18		17		16		15		14		13		
7													
8	19		20		21		22		23		24		
9													
10	30		29		28		27		26		25		
11													
12	31		32		33		34		35		36		
13													

I, James T. Meek, in a field survey on October 30, 1997, do hereby certify that under requirements of P.A. 74, Michigan P.A. of 1970, the corner points mentioned in lines 1 and 2 above were in conformance with regulations and rules thereof as required in the current manual of survey instructions of the United States Department of the Interior, Bureau of Land Management or by a decree of a Court of Law and/or that the corner points mentioned in lines 3, 4 and 5 above were in conformance with the rules of the Michigan Board of Land Surveyors or by a Decree of a Court of Law; established, re-established, monumented, re-monumented, recovered, found as expressed below:

NOTE: Not more than 4 corners, all in the same town and range, may be recorded on this certificate.

A. Description of original monument and accessories and/or subsequent restoration:
 Original Survey East Bdy. T15NR10E, 1835, Harvey Parke, D.S.

- M-1 Corner of Townships 15 and 16 North, Ranges 10 and 11 East
 Post
 B. Ash 17", S43°E, 14 links
 Birch 10", N62½°W, 19 links
 County surveyors record: none
 Recorded surveys: L3, P45; L4, P12
 LCRC: none

SURVEY &
 REMONUMENTATION

JAN 22 1998

SECTION

B. Description of corner evidence found and/or method applied in restoring or reestablishing corner:

- M-1 Corner of Townships 15 and 16 North, Ranges 10 and 11 East

Found 1" pipe bent at surface of pavement
 At intersection of Kilmanagh Rd. and
 Gagetown Rds.

Accepted as the best available evidence
 of original corner position

C. Description of monument for corner and accessories established to perpetuate locating the position of the corner:


- M-1 Corner of Townships 15 and 16 North, Ranges 10 and 11 East

¾" iron in mon box at pipe location

From which:

- Road sign post bears N64°E, 36.6'
 Tag in PP bears S47°E, 69.1'
 Road sign post bears S56°W, 37.5'
 Telephone box bears N37°W, 56.4'

Signed by [Signature] Date _____
 Surveyor's Michigan License No. 39089

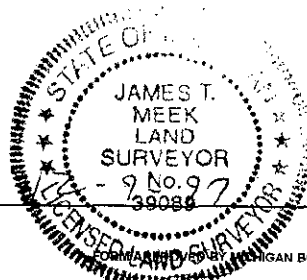

APPROVED AT PEER BOARD MEETING Nov. 25 1987 RLB