

# SURVEY & REMONUMENTATION

JAN 22 1998

*Re-Mon Liber 1 Page 129*

## REMONUMENTATION SECTION

## LAND CORNER RECORDATION CERTIFICATE Filing Requirement of Act 74, Mich. P.A. 1970

For Corners in

	<u>Huron</u> (County)	Located in:	Corner Code #
1. Public Land survey	Winsor	T <u>16</u> N R <u>10</u> E	<u>B-13</u> C-13
		T _____ R _____	_____
		T _____ R _____	_____
		T _____ R _____	_____
2. Property Controlling in Section	S _____	T _____ R _____	_____
	S _____	T _____ R _____	_____
3. Miscellaneous	S _____	T _____ R _____	_____

STATE OF MICHIGAN  
HURON COUNTY  
RECORDED

9 DEC 97 11:13 A.M.

FRANCES L. HOLDWICK  
REGISTER OF DEEDS

Register of Deeds Stamp & File Number

4. Lot No. \_\_\_\_\_, Recorded Plat \_\_\_\_\_  
5. Private Claims \_\_\_\_\_

I, James T. Meek, in a field survey on October 30, 1997, do hereby certify that under requirements of P.A. 74, Michigan P.A. of 1970, the corner points mentioned in lines 1 and 2 above were in conformance with regulations and rules thereof as required in the current manual of survey instructions of the United States Department of the Interior, Bureau of Land Management or by a decree of a Court of Law and/or that the corner points mentioned in lines 3, 4 and 5 above were in conformance with the rules of the Michigan Board of Land Surveyors or by a Decree of a Court of Law; established, re-established, monumented, re-monumented, recovered, found as expressed below:

	A	B	C	D	E	F	G	H	I	J	K	L	M
2	6	5	4	3	2	1							
3													
4	7	8	9	10	11	12							
5													
6	13	17	16	15	14	13							
7													
8	19	20	21	22	23	24							
9													
10	30	29	28	27	26	25							
11													
12	31	32	33	34	35	36							
13													

**NOTE: Not more than 4 corners, all in the same town and range, may be recorded on this certificate.**

A. Description of original monument and accessories and/or subsequent restoration:  
Original Survey South Bdy. T16NR10E, 1835, Harvey Parke, D.S.

B-13 South ¼ Corner of Section 31  
Post  
W. Oak 30", N47°W, 42 links  
Elm 9", N43°E, 19 links

C-13 Corner of Sections 31 and 32  
Post  
Elm 22", N30°W, 24 links  
Lynn 11", N63½°E, 51 links

County surveyors record; ¾" iron  
Recorded surveys; L1, P477; L3, P428  
No LCRC

County Surveyors Record: ¾" iron  
Recorded surveys; L3, P428; L3, P237  
No LCRC

B. Description of corner evidence found and/or method applied in restoring or reestablishing corner:

B-13 South ¼ Corner of Section 31

Found 1" iron in mon box  
Field line bears North  
East 15'± centerline of ditch bears South

Accepted as the best available evidence of the original corner position.

C-13 Corner of Sections 31 and 32

Found 1" iron in mon box  
At intersection of Kilmanagh & Risky Rds.

Accepted as the best available evidence of the original corner position.

C. Description of monument for corner and accessories established to perpetuate locating the position of the corner:

B-13 South ¼ Corner of Section 31

1" iron in mon box

From which:

½" iron flush w/grd. bears N45°E, 30.0'  
½" iron flush w/grd. bears S45°E, 20.0'  
½" iron flush w/grd. bears S45°W, 20.0'  
½" iron flush w/grd. bears N45°W, 30.0'


C-13 Corner of Sections 31 and 32

1" iron in mon box

From which:

½" iron flush w/grd. bears N45°E, 33.0'  
Road sign post bears S42°E, 39.6'  
Tag in PP bears S43°W, 43.8'  
Road sign post bears N25°W, 36.5'  
1" iron in mon box bears East, 7.95'

Signed by James T. Meek Date \_\_\_\_\_  
Surveyor's Michigan License No. 39089

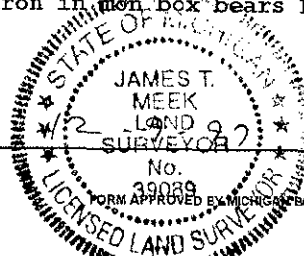

APPROVED AT PEER BOARD MEETING, Nov. 25, 1997 RLB