

SURVEY & REMONUMENTATION

JAN 22 1998

Re-Mon Liber 1 Page 129

LAND CORNER RECORDATION CERTIFICATE
Filing Requirement of Act 74, Mich. P.A. 1970

REMONUMENTATION SECTION

For Corners in Huron (County) Located in: _____ Corner Code # _____

1. Public Land survey	Winsor	T <u>16</u> N R <u>10</u> E	<u>B-13</u>
		T _____ R _____	<u>C-13</u>
		T _____ R _____	_____
		T _____ R _____	_____
2. Property Controlling in Section	S _____	T _____ R _____	_____
	S _____	T _____ R _____	_____
3. Miscellaneous	S _____	T _____ R _____	_____

4. Lot No. _____, Recorded Plat _____

5. Private Claims _____

STATE OF MICHIGAN
HURON COUNTY
RECORDED

9 DEC 97 11:13 A.M.

FRANCES L. HOLDWICK
REGISTER OF DEEDS

Register of Deeds Stamp & File Number

	A	B	C	D	E	F	G	H	I	J	K	L	M
2	6		5		4		3		2		1		
3													
4	7		8		9		10		11		12		
5													
6	18		17		16		15		14		13		
7													
8	19		20		21		22		23		24		
9													
10	30		29		28		27		26		25		
11													
12	31		32		33		34		35		36		
13													

I, James T. Meek, in a field survey on October 30, 1997, do hereby certify that under requirements of P.A. 74, Michigan P.A. of 1970, the corner points mentioned in lines 1 and 2 above were in conformance with regulations and rules thereof as required in the current manual of survey instructions of the United States Department of the Interior, Bureau of Land Management or by a decree of a Court of Law and/or that the corner points mentioned in lines 3, 4 and 5 above were in conformance with the rules of the Michigan Board of Land Surveyors or by a Decree of a Court of Law; established, re-established, monumented, re-monumented, recovered, found as expressed below:

NOTE: Not more than 4 corners, all in the same town and range, may be recorded on this certificate.

A. Description of original monument and accessories and/or subsequent restoration:
Original Survey South Bdy. T16NR10E, 1835, Harvey Parke, D.S.

B-13 South 1/4 Corner of Section 31
Post
W. Oak 30", N47°W, 42 links
Elm 9", N43°E, 19 links

County surveyors record; 3/4" iron
Recorded surveys; L1, P477; L3, P428
No LCRC

C-13 Corner of Sections 31 and 32
Post
Elm 22", N30°W, 24 links
Lynn 11", N63 1/2°E, 51 links

County Surveyors Record: 3/4" iron
Recorded surveys; L3, P428; L3, P237
No LCRC

B. Description of corner evidence found and/or method applied in restoring or reestablishing corner:

-13 South 1/4 Corner of Section 31

Found 1" iron in mon box
Field line bears North
East 15'± centerline of ditch bears South

Accepted as the best available evidence of the original corner position.

C-13 Corner of Sections 31 and 32

Found 1" iron in mon box
At intersection of Kilmanagh & Risky Rds.

Accepted as the best available evidence of the original corner position.

C. Description of monument for corner and accessories established to perpetuate locating the position of the corner:

-13 South 1/4 Corner of Section 31

1" iron in mon box


From which:
1/2" iron flush w/grd. bears N45°E, 30.0'
1/2" iron flush w/grd. bears S45°E, 20.0'
1/2" iron flush w/grd. bears S45°W, 20.0'
1/2" iron flush w/grd. bears N45°W, 30.0'

C-13 Corner of Sections 31 and 32

1" iron in mon box

From which:
1/2" iron flush w/grd. bears N45°E, 33.0'
Road sign post bears S42°E, 39.6'
Tag in PP bears S43°W, 43.8'
Road sign post bears N25°W, 36.5'
1" iron in mon box bears East, 7.95'

Recorded by [Signature] Date _____
Surveyor's Michigan License No. 39089

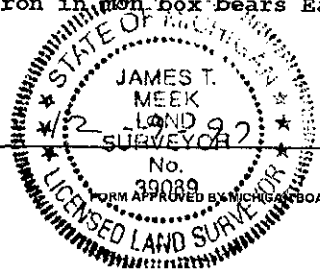

APPROVED AT PEER BOARD MEETING, Nov. 25, 1997 RLB