

SURVEY & REMONUMENTATION

JAN 22 1998

Re-Mon Liber 1 Page 128

LAND CORNER RECORDATION CERTIFICATE
Filing Requirement of Act 74, Mich. P.A. 1970

REMONUMENTATION SECTION

For Corners in

	<u>Huron</u> (County)	Located in:	Corner Code #
1. Public Land survey	Winsor	T <u>16 N</u> R <u>10 E</u>	D-13 E-13
		T _____ R _____	
		T _____ R _____	
		T _____ R _____	
2. Property Controlling in Section	S _____	T _____ R _____	
	S _____	T _____ R _____	
3. Miscellaneous	S _____	T _____ R _____	
4. Lot No. _____, Recorded Plat _____			
5. Private Claims _____			

STATE OF MICHIGAN
HURON COUNTY
RECORDED
9 DEC 97 11:13 A.M.
FRANCES L. HOLDWICK
REGISTER OF DEEDS
Register of Deeds Stamp & File Number

	A	B	C	D	E	F	G	H	I	J	K	L	M
2	6		5		4		3		2		1		
3													
4	7		8		9		10		11		12		
5													
6	16		17		16		15		14		13		
7													
8	19		20		21		22		23		24		
9													
10	30		29		28		27		26		25		
11													
12	31		32		33		34		35		36		
13													

I, James T. Meek, in a field survey on October 30, 1997, do hereby certify that under requirements of P.A. 74, Michigan P.A. of 1970, the corner points mentioned in lines 1 and 2 above were in conformance with regulations and rules thereof as required in the current manual of survey instructions of the United States Department of the Interior, Bureau of Land Management or by a decree of a Court of Law and/or that the corner points mentioned in lines 3, 4 and 5 above were in conformance with the rules of the Michigan Board of Land Surveyors or by a Decree of a Court of Law; established, re-established, monumented, re-monumented, recovered, found as expressed below:

NOTE: Not more than 4 corners, all in the same town and range, may be recorded on this certificate.

A. Description of original monument and accessories and/or subsequent restoration:
Original survey South Bdy. T16NR10E, 1835, Harvey Parke, D.S.

D-13	South 1/4 Corner of Section 32 Post Beech 12", N82°E, 18 links Maple 18", N70°W, 26 links County surveyors record; 3/4" iron Recorded surveys: none LCRC: none	E-13	Corner of Sections 32 and 33 Post Lynn 28", N71°W, 10 1/2 links Beech 10", N22°E, 2 links County surveyors record; 3/4" iron Recorded surveys: none LCRC: none
------	--	------	--


B. Description of corner evidence found and/or method applied in restoring or reestablishing corner:

D-13	South 1/4 Corner of Section 32 Found 1" iron in mon box 3' South of centerline Kilmanagh Rd. Field line bears North Accepted as the best available evidence of the original corner position.	E-13	Corner of Sections 32 and 33 Found 1" iron in mon box At intersection of Kilmanagh & Pobanz Rds. Accepted as the best available evidence of the original corner position.
------	--	------	--

C. Description of monument for corner and accessories established to perpetuate locating the position of the corner:

D-13	South 1/4 Corner of Section 32 1" iron in mon box From which: 1/2" iron w/cap in mon box bears East 6.65' 1/2" iron flush w/grd. bears S10°E, 39.5' Tag in PP bears S15°W, 38.0' Telephone cable box post bears N2°W, 34.5'	E-13	Corner of Sections 32 and 33 Set 1/2" iron w/cap #39089 over 1" iron in mon box From which: West leg direct. sign bears N24°E, 37.2' Road sign post bears S50°E, 37.4' Tag in PP bears S30°W, 46.6' 1/2" iron w/cap in mon box bears East, 12.0'
------	---	------	--

Surveyed by James T. Meek Date _____
Surveyor's Michigan License No. 39089

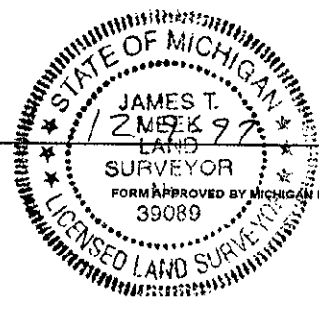

APPROVED AT PEER BOARD MEETING, Nov. 25, 1997 RLB